

MISSISSIPPI DEPARTMENT OF NATURAL RESOURCES

Bureau of Land and Water Resources

Southport Mall

P.O. Box 10631

Jackson, Mississippi 39209

WATER WELL DRILLERS LOG

CODED

LINCOLN
N 13

12-11-1984 Grenn Water Well Lincoln
 date well completed firm name county well located

LANDOWNER: Kim Bridge
 Rt. 1, Box 559
 Brookhaven, Ms.
 (mailing address)

description of formations encountered	from	to
Clay	1	20
sand & gravel	20	55
white clay	55	90
blue clay	90	130
white clay	130	150
sand	150	208

CODED

WELL LOCATION:
 sec 11 T 6 N R 9 E
 S W
 11 miles SE of Brookhaven
 (distance) (direction) (nearest town)

WELL PURPOSE: home
 (home, irrigation, municipal, industrial)

WELL COMPLETION DATA:

- (1) diameter (inches) 4
- (2) total depth (feet) 208
- (3) static water level (feet) 96 below above top of ground.
- (4) casing PVC 198' (material) (depth)
 4" if telescope see back. (size)
- (5) screen 10' 198' (length) (depth to top)
 .010 PVC (size) (material)
- (6) pump 3/4 sub 10 (HP) (yield gpm)
 electricity (type power)
- (7) electric log no (yes or no)

(organization running log)

(8) how well bottom plugged back wash valve

DRILLERS REMARKS:


RECEIVED

APR 16 1985

Department of Natural Resources
 Bureau of Land & Water Resources

If well telescopes please sketch and show depths.

GROUND LEVEL

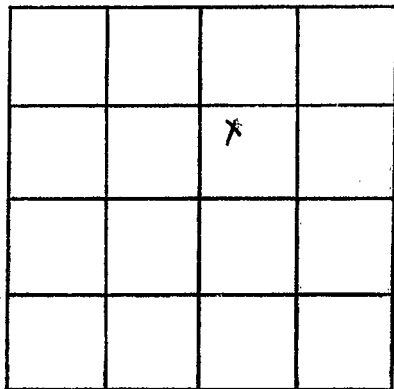

SECTION 11

Please indicate well location X.

ADDITIONAL INFORMATION

If more than one screen,
show locations of each on sketch.