

MISSISSIPPI DEPARTMENT OF NATURAL RESOURCES

Bureau of Land and Water Resources

Southport Mall

P.O. Box 10631

Jackson, Mississippi 39209

WATER WELL DRILLERS LOG

CODED

LINCOLN
N 15

12-3
date well completed

1984

Grenn Water Well
firm name

Lincoln
county well located

LANDOWNER: Judy Allen

Rt. 4, Box 82

Brookhaven, Ms.
(mailing address)

WELL LOCATION:

sec. 34 T 6 N S R 9 E W

11 miles E of Bogue Chitto
(distance) (direction) (nearest town)

WELL PURPOSE: home
(home, irrigation, municipal, industrial)

WELL COMPLETION DATA:

- (1) diameter (inches) 4
- (2) total depth (feet) 113
- (3) static water level (feet) 63 below top of ground.
- (4) casing PVC 103
(material) (depth)
4" if telescope see back.
(size)
- (5) screen 10' 103'
(length) (depth to top)
.010 PVC
(size) (material)
- (6) pump 1/2 sub 10
(HP) (yield gpm)
electricity
(type power)
- (7) electric log no
(yes or no)
(organization running log)

(8) how well bottom plugged back wash valve

description of formations encountered

Citronelle

from

to

1

113

CODED

RECEIVED


APR 16 1985

DRILLERS REMARKS:

Department of Natural Resources
Bureau of Land & Water Resources

If well telescopes please sketch and show depths.

GROUND LEVEL

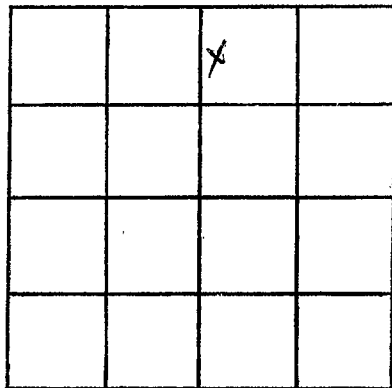

SECTION 34

Please indicate well location X.

ADDITIONAL INFORMATION

If more than one screen,
show locations of each on sketch.