

**MISSISSIPPI DEPARTMENT OF ENVIRONMENTAL QUALITY**

Office of Land and Water Resources

P. O. Box 10631

Jackson, MS 39289-0631

**WATER WELL DRILLERS LOG**

COUNTY WELL LOCATED <u>Lincoln</u>	
WELL NUMBER <u>N-16</u>	CODED
DATE WELL COMPLETED <u>1/28/03</u>	

PERMIT NUMBER <u>Green Water Well #</u>
NAME OF DRILLING FIRM <u>Supply, Inc.</u>

NAME & MAILING ADDRESS OF LANDOWNER <u>Robin King</u>			
<u>1246 Plez Dr., Monticello, MS</u>			
Latitude: Longitude:			
WELL LOCATION.	SEC <u>15</u>	TOWNSHIP <u>6 N S</u>	RANGE <u>9 E W</u>
DISTANCE <u>8</u> Miles	DIRECTION <u>SE</u>	NEAREST TOWN <u>Brookhaven</u>	
OTHER LANDMARK			
WELL PURPOSE <input checked="" type="checkbox"/> Home, <input type="checkbox"/> Irrigation, <input type="checkbox"/> Municipal, <input type="checkbox"/> Industrial, <input type="checkbox"/> Fish Pond, etc.			

PUMP DATA		
PUMP TYPE (Circle One): <input checked="" type="checkbox"/> Submersible, <input type="checkbox"/> Turbine, <input type="checkbox"/> Jet, <input type="checkbox"/> Flowing Well, Other (Describe) _____		
POWER TYPE (Circle One): <input checked="" type="checkbox"/> Electric, <input type="checkbox"/> Tractor, <input type="checkbox"/> Diesel, <input type="checkbox"/> Gasoline, <input type="checkbox"/> Butane, Other (Describe) _____	H/P <u>3/4</u>	
DESCRIPTION OF FORMATIONS ENCOUNTERED	FROM	TO
<u>red clay</u>	<u>0</u>	<u>16</u>
<u>sand &amp; gravel</u>	<u>16</u>	<u>80</u>
<u>white clay</u>	<u>80</u>	<u>135</u>
<u>blue clay</u>	<u>135</u>	<u>155</u>
<u>streaky</u>	<u>155</u>	<u>180</u>
<u>sand</u>	<u>180</u>	<u>251</u>
<u>white clay</u>	<u>251</u>	<u>251</u>
<b>RECEIVED</b>		
<b>FEB 13 2003</b>		
<b>BY: OLWFR</b>		
Top of Lap Pipe or Reduction in Casing		
FEET	IF TELESCOPED OR MORE THAN ONE SCREEN: USE BACK PAGE	

WELL DATA		
Well Depth <u>250'</u>	Casing Diameter (In.) <u>4"</u>	Casing Length (Ft.) <u>240'</u>
Type of Casing <u>PVC</u>	Hole Depth <u>251'</u>	Depth to Static Water Level <u>97'</u>
TYPE OF COMPLETION: (Circle One or More): <input checked="" type="checkbox"/> Gravel Packed, <input type="checkbox"/> Underreamed, <input type="checkbox"/> Telescoped, <input type="checkbox"/> Natural Development, <input type="checkbox"/> Open Hole, <input type="checkbox"/> Other (Describe) _____		
WELL GROUTED TO A DEPTH OF <u>10 FEET</u> Type Grout (circle one): Cement, Bentonite, <input checked="" type="checkbox"/> Mix		

SCREEN DATA		
Diameter - Inches <u>4</u>	Length - Feet <u>10</u>	Slot Size - Inches <u>10/10</u>
Screen Type <u>PVC</u>	Depth to Bottom - Feet <u>250</u>	

I certify that the well was drilled, constructed and completed in accordance with all applicable Requirements of the Mississippi Department of Environmental Quality and/or the Mississippi Department of Health regulations and state laws.


Brian McClendon 664  
Signature of Licensed Driller and License No.

1/29/03  
Date

Additional Information Required On Back

If well telescopes please sketch and show depths.

GROUND LEVEL

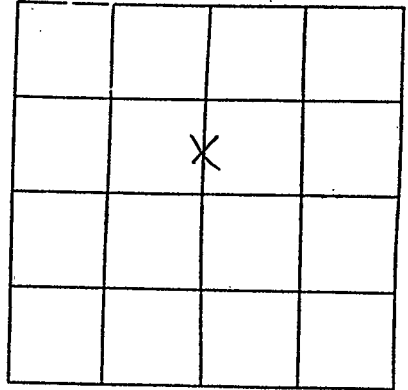

SECTION 15

Please indicate well location X.

Pump Capacity (GPM)	No. of Stages	Setting Depth	
10	12	130	FT.

PUMP TEST

Well yielded 11 GPM with  
 a drawdown of 1 ft.  
 after 1 hours of pumping

LOG DATA

TYPE OF LOG RUN (Circle One): No Log Run  
 Electric, Gamma Ray, Density, Sonic, Neutron,  
 Other (Describe) \_\_\_\_\_

Name of Organization Running Log

GEOLOGIC DATA (Office Use Only)

Surface Elev.	Geologic Unit	Unit Thickness	Depth to Top
Subs. SWL	Date	Analysis	Aquifer Test

Driller's Remarks

If more than one screen,  
 show location of each on sketch.