

a	State W	ell Report	
County: Lincoln	Pa Pa	art 1	For Office Use Only:
County. <u>1-1100</u>	Mississippi Department	of Environmental Quality	Aquifer:
Permit #:	Office of Land an	nd Water Resources	well#: <u>N42</u>
GRENN WATER WELL &		ox 10631	
Driller: SUPPLY, INC.		S 39289-0631	L. S. Elevation:
Date drilling completed: <u>4-16-13</u>		961-5210 (028 (fr-r)	$\mathbf{E} = \mathbf{H}$
	(601)354	-6938 (fax)	E-log #:
State Law requires that this rep 30 days of completion of drilling		driller in detail and filed w	vith the Department within
Well Owner Inform		Wel	l Location
Owner Name Margaret Bre	nt	Latitude: 31 ° 26. 66)" Longitude: <u>90° 17- 436</u> "
Mailing Address: 2234 Malla		AC Method of Lat/Long (circle or	
Maning Address: <u>~~ 3 1 1 100 1 C.</u>	rica pr		GP\$, Survey-grade GPS
<u> </u>			
Ruth, Ms. 2 City St	39662_ ate Zip Code		Twn <u>6N Rng 9E</u>
City St	ate Zip Code	NW SW Distance Direction	Nearest Town
Telephone No. (601) 8.35-03	76	Distance Direction	of Ruth
	Well I	Data	
Purpose of Well (circle one) Home In	dustrial Public Supply	Irrigation Fish Culture	Other:
Date well drilling started: $\frac{1}{4} - \frac{1}{2}$			-13
			<u> </u>
If flowing, method of flow regulation: V	alve Other (d	lescribe)	······
Static Water Level: 65 feet :	above of below (circle one)	and surface Date measured:	476-13
·			
Method of Measurement (circle one)	steel tape electric tape		
Hole depth: 137 Well d	epth: 130	Well grouted to a depth of _	feet
Type of grout (circle one): Cement	Bentonite Mix		
Casing length: (20) feet Ca	sing diameter: 4		PVC.
· · · · · · · · · · · · · · · · · · ·			D.C.
Screen length:feet Sc	reen diameter: <u> </u>		PVC
Screen slot size: (010) inches	Setting depth: From_	120 feet to 13	feet
Type of completion (circle all applicable): Gravel packed Under	rreamed Telescoped Ope	n hole Natural Development
	Other (describe):		
Top of lap pipe or reduction in casing:		elescoped or more than one so	reen, describe on back of page
Logs run (circle all applicable):(No log		-	
Name of organization running log(s):	······································	•	
I certify that the well was drilled, cons	structed, and completed in	accordance with all applicab	e requirements of the Mississip
Department of Environmental Quality	_		
GRENN WATER WELL & SUPP			
	R-00000664	Brian	MCCD. Jon
Print Name of Water Well Contractor an	ad License No.	Signature	of Water Well Contractor
			to the have by I know \$ V
			MAY 02 20
			DVL ALL
			BY: OLV

If well telescopes please sketch below and show depths.

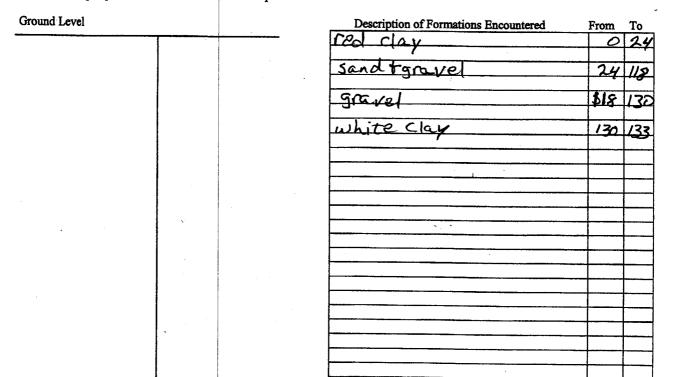

If more than one screen, show location of each on sketch

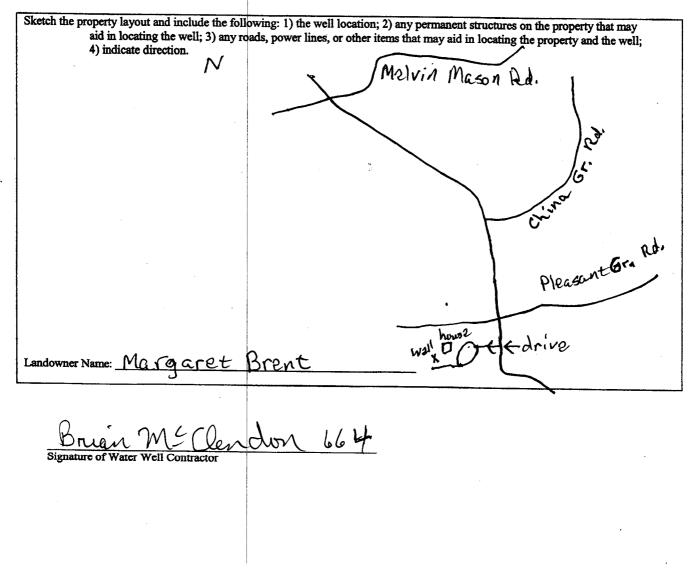

County: Lincoln	Pump Installe	Part 2 Pump Installer's Completion Report Mississippi Department of Environmental Quality Office of Land and Water Resources	
Permit #:	Office of Lan		
Driller: GRENN WATER WELL		P.O. Box 10631	
& SUPPLY, INC. Date completed: 4/17/15		Jackson, MS 39289-0631 (601)961-5210	
Date completed		(601)354-6938 (fax)	
This report should be prepar installation of pump.	red by the pump installer in de	etail and filed with the Depa	rtment within 30 days of the
Well Owner Information		Well Location	
Owner Name: Margaret Brent		Latitude: 31 26 66	9 ["] Longitude: 90°17 '48.
Mailing Address: 2234 Ma	Maliev Dr	Method of Lat/Long (circ	le one): Conventional Survey,
<u> </u>		USGS quad, d	Land-held GPS, Survey-grade GP
Kvth City	Mis 39662 State Zip Code	<u>SE 14 NW</u> 14 Sec	<u>34</u> Twn <u>6 N</u> Rng <u>9</u> E
•		Distance Direction	
Telephone No. (601) 835	-0376	<u> </u>	of <u>Ruth</u>
Pump	Туре		Power Type
Circle	one		Circle one
Air Lift Jet	Submersible	Diesel Engine Ga	soline Engine Natural G
Bucket Piston	Turbine	Electric Motor Hi	and Tractor P1
Centrifugal Rotary	Flowing Well		ther (specify):
Other (specify):		Horse Power Rating of M	iotor:
Date Pump Installed: 4/17	/13	Setting Depth:90	jfeet
Rated Pump Capacity: 10	Gallons Per Minute	Number of Stages:	9
Pump Test Data		Method of	Measuring Water Level
Date Well Tested: 4/17/	3		Circle one
Static Water Level (A): <u>65</u> Feet Below Land Surface			Measuring Line Steel Tape
Pumping Water Level (B): 71	Feet Below Land Surface	Other (specify):	
Drawdown [(B) - (A)]: Feet Below Land Surface		For flowing well, measure	ed shut in head:fe
Test Pumping Rate: 12	Gallons Per Minute	Well yielded 12	GPM with a drawdown of
Duration of Pump Test (minimum 4	hours): <u> </u>	1 4	erhours of pumpi
I HEREBY CERTIFY that the above	78 Statements are two to the house		
WILLIAM L. HARDIN, V,		tor my knowledge.	RECE

• ٠ ...

BY: OLWR