
	- State W	ell Report	
County: Lincoln		Part 1	For Office Use Only:
Permit #		t of Environmental Quality	Aquifer:
GRENN WATER WELL &		and Water Resources Box 10631	Well#: N45
Driller: SUPPLY, INC.		IS 39289-06 31	L. S. Elevation:
Date drilling completed: 8-15-13		961-5210 4-6938 (fax)	
	J (001)33	4-0938 (IAX)	E-log #:
State Law requires that this rep 30 days of completion of drilling	g of the well.	driller in detail and filed w	rith the Department within
Well Owner Inform	ation	Wel	l Location
Owner Name Jason M	<pre>cDonald)</pre>		" Longitude: 90 . 20. 373"
Mailing Address: 2572 E. Li	ncoln Rd.	Method of Lat/Long (circle of	ne): Conventional Survey,
		USGS quad, Rand-held	GPS, Survey-grade GPS
Brookhaven, M	15. 39601	SE4. SW1/4 Sec_7	Twn GN Rng 9E
· · · · · · · · · · · · · · · · · · ·	•	INE	
Telephone No. (60/) 669-030	03		of Brookhaven
	Weil	Data	
Purpose of Well (circle one) Home In	dustrial Public Supply	Irrigation Fish Culture	Other:
Date well drilling started: 8-15-1	3 Date	well drilling completed: 8	-15-13
If flowing, method of flow regulation: Va		lescribe)	
Static Water Level: 50 feet a			8-15-13
Method of Measurement (circle one)	steel tape electric tape	air line other:	
Hole depth:O Well de	pth: 96	Well grouted to a depth cf_	10 feet
Type of grout (circle one): Cement	Bentonite Mix	• • •	
Casing length: <u>66</u> feet Cas	ing diameter: <u>4</u>	inches Type of casing:	pvc
Screen length: <u>30</u> feet Scr	een diameter:4_	inches Type of screen:	OVC
Screen slot size: .010 inches	Setting depth: From _	feet to	<u>fect</u>
Type of completion (circle all applicable)	: Gravel packed Under	rreamed Telescoped Oper	a hole Natural Development
	Other (describe):		
Top of lap pipe or reduction in casing:	feet. If to	elescoped or more than one sci	een, describe on back of page
Logs run (circle all applicable): No log n	Electric Gamma Ray	Density Sonic Neutron	Other:
Name of organization running log(s):		•	
I certify that the well was drilled, const	ructed, and completed in	accordance with all applicable	e requirements of the Mississippi
Department of Environmental Quality		partment of Health regulation	is and state laws.
GRENN WATER WELL & SUPPI	LY, INC.	\circ ·	MARA I
	₹-00000664	Krien	W/-llendors
Print Name of Water Well Contractor and	d License No.	Signature of	f Water Well Contractor
			11. 2.7.201
			and a second
			BY QEWE

		1	÷.	W	÷
 4 6 	- 1	- <u>3</u> - 2	1 C -	56.55	6-18
- ನೋಜನ್		1. A.	C 2 -	- 19 H	2 5

If well telescopes please sketch below and show depths.

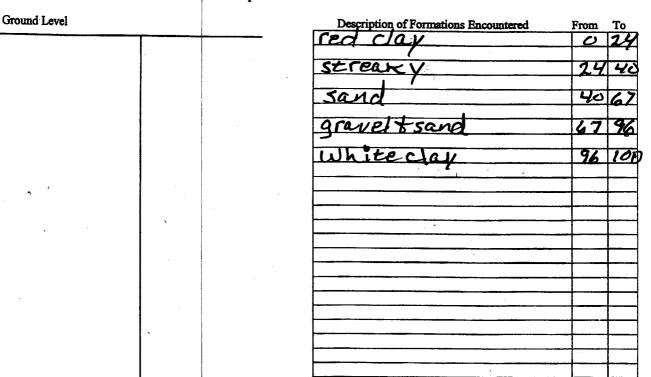

If more than one screen, show location of each on sketch

Sketch the property layout and include the following: 1) the well location; 2) any permanent structures on the property that may aid in locating the well; 3) any roads, power lines, or other items that may aid in locating the property and the well; 4) indicate direction. 84 Hwy E. E Lincoln Dr. Bechel Temate Rel Mallaieu Dr. Nell weilmen Dr. ambert Rd. Landowner Name: Jason Mc Donald

664 M Signature of Water ell Contractor

County: Line (Martin Martin Ma	Pump Installer's Mississippi Department Office of Land a P.O. B Jackson, M (601)9 (601)354	art 2 Completion Report t of Environmental Quality nd Water Resources lox 10631 S 39289-0631 061-5210 L-6938 (fax)	Aquifer: Well #: Elevation:	ice Use Only:	
This report should be prepared by th installation of pump.	ne pump installer in detai	l and filed with the Departs	ment within 30 da	ys of the	
Well Owner Informat	ion	Well Location			
Owner Name: JASON Mc	Latitude: 31°30'0	Longitude:)	520372		
Mailing Address: 2572 E. Li	Method of Lat/Long (circle				
Brook Marcer City State	USGS quad, Hand-held GPS, Survey-grade GPS <u>SE 45004 Sec 7 Twn GN Rng 9E</u> NE Distance Direction Nearest Town				
Telephone No. (601) 669-030	03	<u></u>	of Brook	haven	
Pump Type			Power Type	· · · · · · · · · · · · · · · · · · ·	
Circle one			Circle one		
Air Lift Jet 🤇	Submersible	Diesel Engine Gaso	line Engine	Natural Gas	
Bucket Piston	Turbine	Electric Motor Hand	đ	Tractor PTO	
Centrifugal Rotary	Flowing Well	Windmill Othe	r (specify):		
Other (specify):		Horse Power Rating of Mot	1111		
Date Pump Installed: 8-16-13		Setting Depth: 40	····	feet	
Rated Pump Capacity:25	Gallons Per Minute	Number of Stages:			
Pump Test Data			leasuring Water]	level	
Date Well Tested: <u>8-16-13</u>			Circle one		
Static Water Level (A): <u>50</u> Feet	Below Land Surface		easuring Line	Steel Tape	
Pumping Water Level (B): 62 Feet H	Below Land Surface	Other (specify):			
Drawdown [(B) - (A)]: 12 Feet 1	Below Land Surface	For flowing well, measured	shut in head:	feet	
2~	Gallons Per Minute	Well yielded 25	GPM with a d		
Duration of Pump Test (minimum 4 hours):			1.1	urs of pumping	
I HEREBY CERTIFY that the above statem MICHAEL W. KEES, RPO-000008 Print Name of Pump Installer and License N	801	my knowledge.	Installer		