	STATE WE	LL REPORT	444
County: Lincoln_		rt 1	For Office Use Only:
Permit #:	Driller	's Log	Well #: lik
Driller: James M. Wells	Office of Land and	of Environmental Quality I Water Resources	Aquifer:
Date drilling completed: 1-24-19	P.O. Bo	x 2309	E-Log #:
		39225-2309 1-5210	
-	(601)360-	)535 (fax)	
State Law requires that this report I Department at the above address wi	and so auys of completio	e holder responsible for the net of the net of the net of the self	he work and filed with the or borehole
Well Owner Information (Landowner if borehole is not for a	מר		hole Location
Owner Name: Robert Kyz		ide: <u>31° 78. 35</u> Nor 31-28-35	pitude. 90°14 574
Mailing Address:	Metho	d of Lat/Long (check one	): Conventional Survey,
4044 Hebert Tr.			PS, Survey-grade GPS
Brookhaven M5		N 14 NE 14, Sec.	24 TUNR9E
Telephone No. (LOL) 133-123		Miles of nce) (Direction)	(Nearest Town)
Date drilling started: 1.24-19 Date d	Well / Borehol rilling completed: <u>1-24</u>	19 Hole depth: 150	Hole diameter: 7%"
Location of the source of any surface wa	ter used for drilling: <b>P</b>	unning creek	
Method of dosing and volume of Chlorine			
Logs run (rirrle all applicable) No log -		iopment: <u>Granue</u>	Chilorine
Logs run (circle all applicable) No log run	Electric Gamma Ray	Density Sonic Neutron	Other:
Name of organization running log(s):			
Purpose of borehole (circle one): Water W		ogical Investigation G	round Source Hent ARM 8 2013
Seismic		)	
		ion, skip the remainder o	of this block BYOLWR
Purpose of Well (circle all applicable): Ho	me Industrial Public	Supply Irrigation Fi	sh Culture
Other (describe): Cattle			
If a flowing well, method of flow regulation	on: Valve (	Other (describe)	
E A	bove or below] land su (circle one)		1-24-19
Method of measurement (circle one)	I tape Electric tape Ai	line Other (describe)	
Well depth: $150$ Well grouted to a de	oth of: 16 feet Ty	e of grout (circle one N	eat Cement) Pontonite Ilin
Casing length: <u>130</u> feet Casin	g diameter: <u> </u>	inches Type of cas	
Screen length:feet Scre	en diameter: <u>4</u>	inches Type of scr	
Screen slot size: .008 inches	Setting depth: From	130feet to	1.50 feet
Type of completion (circle all applicable)	Gravel packed Underr		Natural Development
Other (describe):		·	
Top of lap pipe or reduction in casing:	feet		
If telescoped	or more than one scree	1. describe on next nage	

٠


-

County:	Lincoln
Permit #: _	

	F	or Office Use Only:	
Well	<b>#:</b>	Nick	

The sketch below only required for water wells

If well telescopes, show depths on sketch.

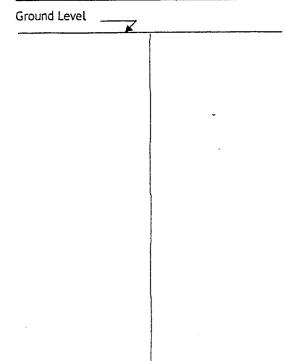

Description of formations encountered must be provided for all wells and boreholes, unless specifically exempted by regulations

Description of Formations Encountered	From (depth)	To (depth)
tapsn; 1	Ground level	
Clay	1	30
Sand	30	50
clay.	50	100
Jand & gravel	100	150
· · ·		

If more than one screen, show location of each on sketch

Sketch the property layout and includ 1) the well location 2) any permanent structures on t		aid in locating the v	vell	
3) any roads, power lines, or oth 4) north arrow	er items that may aid	in locating the prop	erty and the well <b>X</b> Wel	l
			Xwc	RECEIVED
				MAR 0.8 20%
				BYOLWR
	8			
Landowner Name: Rober	t Kuzar			
I HEREBY CERTIFY that the well/ requirements of the Mississippi De if applicable, and state laws.	orehole was drilled	I, constructed, and nmental Quality a	d completed in accordanc nd the Mississippi Departr	e with all applicable nent of Health regulations,
	0005889	2-14-19	Jame 1	· (re Co
requirements of the Mississippi De if applicable, and state laws.	porehole was drilled epartment of Enviro	I, constructed, and nmental Quality a <u>J-14-19</u> Date	Ind the Mississippi Departr	e with all applicable

Form: OLWR-SWR-1A (4/13)

	STATE WELL REPORT			
County:Coln	Part 2	For Office Use Only:		
Permit #:	Pump Installer's Completion Report Mississippi Department of Environmental Quality	Well #: 277 NG6		
Driller: James M. Wells	Office of Land and Water Resources P.O. Box 2309			
Date completed: 1-24-19	Jackson, MS 39225-2309	Aquifer:		
<u>Copy information from block on Part 1</u>	(601)961-5210 (601) 360-0535 (fax)			
This part of the report must be completed of the report must be attached and both p	by a licensed water well contractor or a licensed pub arts filed with the Department at the above address v	mp installer. A copy of Part 1 vithin 30 days of well completion.		
Well Owner Informatic	on Well L	ocation		
Owner Name: Kobert Ky		ngitude: 90°14.57W		
Mailing Address: 4044 Hebert Tr. 5	Method of Lat/Long (check one	e): Conventional Survey,		
4044 Hebert Tr. S	E USGS quad, Hand-held G	PS, Survey-grade GPS		
Brookhaven MS City State		TOM RICE		
Telephone No. (60) 833-123	Zip Code 5W Miles	$\frac{1}{f} \frac{T_{0}N_{R_{1}0E}}{(Nearest Town)}$		
Telephone No. (00) 0 0 - 10 5		(Nearest Town)		
	Pump Type (circle one)			
	gal Flowing Well Jet Piston Rotary Other (de			
Date Pump Installed:	Rated Pump Capacity:	Gällons Per Minute		
Is This Pump (circle one): New Rep		•		
	Power Type (circle one)			
	Tractor PTO Windmill Other (describe): Setting Depth:feet Number			
Date Well Tested:	Pump Test Data for Non Flowing Well Duration of Pump Test (minin	num 4 hours): hours		
Static Water Level (A): <u>50</u> Feet		Feet Below Land Surface		
Drawdown [(B) - (A)]:F	Feet Below Land Surface Test Pumping Rate:	Gallons Per Minute		
Method of measurement (circle one), Steel tape Electric tape Air line Other (describe):				
	Pump Test Data for Flowing Well			
Measured shut in head:feet.		MAR 0.8 2013		
Well yieldedGPM with a di	rawdown of feet after	hours of pumping		
	Meter Installation			
Meter Manufacturer:				
Meter Model Number/Name: Type of Meter:				
Totalizer Register Unit and Multiplier Factor (AF x .001, gal x 1000, etc):				
	Installation Date: Meter installed by:			
Is This Meter (circle one): New Rep				
Important: By submitting the above information you are certifying that this meter was installed to manufacturer standards. For agricultural wells, a list of approved meters is on the MDEQ website.				
I HEREBY CERTIFY that the above statem	nents are true to the best of my knowledge.			
James M. Wells 00005	889 e No. (if applicable) 2-14-19 Signa	e m. willy		
Print Name of Pump Installer and Licens	e No. ( <i>if applicable</i> ) Date Signa	ature of Pump Installer		

• • •

Form: OLWR-SWR-1B (4/13)