

STATE WELL REPORT

338

County: Lincoln
 Permit #: _____
 Driller: Grann Water Well
 Date drilling completed: 4-1-19

**Part 1
 Driller's Log**
 Mississippi Department of Environmental Quality
 Office of Land and Water Resources
 P.O. Box 2309
 Jackson, MS 39225-2309
 (601)961-5555
 (601)961-5228 (fax)

For Office Use Only:

Well #: N68
 Aquifer: _____
 E-Log #: _____

State Law requires that this report be prepared by the license holder responsible for the work and filed with the Department at the above address within 30 days of completion of drilling of the well or borehole.

Well Owner Information <small>(Landowner if borehole is not for a water well)</small>	Well or Borehole Location
Owner Name: <u>Bernie Reed</u>	Latitude: <u>31° 51' 01"</u> Longitude: <u>90° 25' 08"</u>
Mailing Address: _____ <u>Pleasant Grove Rd.</u>	Method of Lat/Long (check one): Conventional Survey _____, USGS quad _____, Hand-held GPS <u>K</u> , Survey-grade GPS _____
<u>Brookhaven</u> MS <u>39601</u>	USGS quad <u>S12NW</u> 1/4 <u>SENE</u> 1/4, Sec. <u>12</u> T. <u>6N</u> R. <u>9E</u>
City State Zip Code	<u>13</u> Miles <u>SE</u> of <u>Brookhaven</u>
Telephone No. <u>(601) 754-7410</u>	(Distance) (Direction) (Nearest Town)

Well / Borehole Data

Date drilling started: 4-1-19 Date drilling completed: 4-1-19 Hole depth: 125 Hole diameter: 7

Location of the source of any surface water used for drilling: _____

Method of dosing and volume of Chlorine used in drilling and development: mudpit + Gravel Pack

Logs run (check all applicable): log run Electric Gamma Ray Density Sonic Neutron Other: _____

Name of organization running log(s): _____

Purpose of borehole (check one): Water Well Geotechnical/Geological Investigation Ground Source Heat Pump Seismic Survey Other (describe) _____

RECEIVED
 MAY 14 2019
 BY OLWR

If drilling is not related to water well construction, skip the remainder of this block

Purpose of Well (check all applicable): Home Industrial Public Supply Irrigation Fish Culture

Other (describe): Windmill

If a flowing well, method of flow regulation: Valve _____ Other (describe) _____

Static Water Level: 15 feet above or below land surface Date measured: 4-1-19
(check one)

Method of measurement (check one) Steel tape Electric tape Air line Other (describe): _____

Well depth: 125 Well grouted to a depth of: 10 feet Type of grout (check one) Neat Cement Bentonite Mix

Casing length: 115 feet Casing diameter: 4 inches Type of casing: PVC

Screen length: 10 feet Screen diameter: 4 inches Type of screen: PVC

Screen slot size: .010 inches Setting depth: From 115 feet to 125 feet

Type of completion (check all applicable) Gravel packed Underreamed Open hole Natural Development

Other (describe): _____

Top of lap pipe or reduction in casing: _____ feet


If telescoped or more than one screen, describe on next page

County: LINCOLN
 Permit #: _____

For Office Use Only:
 Well #: N68

The sketch below only required for water wells

If well telescopes, show depths on sketch.

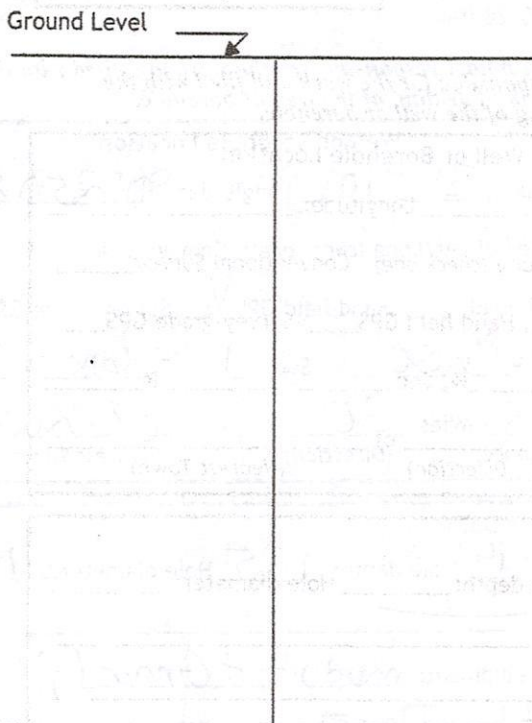


Description of formations encountered must be provided for all wells and boreholes, unless specifically exempted by regulations

Description of Formations Encountered	From (depth)	To (depth)
	Ground level	
SAND & GRAVEL	0	15
CLAY	15	80
SAND & GRAVEL	81	125
SAND PACK	125	

If more than one screen, show location of each on sketch

Sketch the property layout and include the following:

- 1) the well location
- 2) any permanent structures on the property that may aid in locating the well
- 3) any roads, power lines, or other items that may aid in locating the property and the well
- 4) north arrow

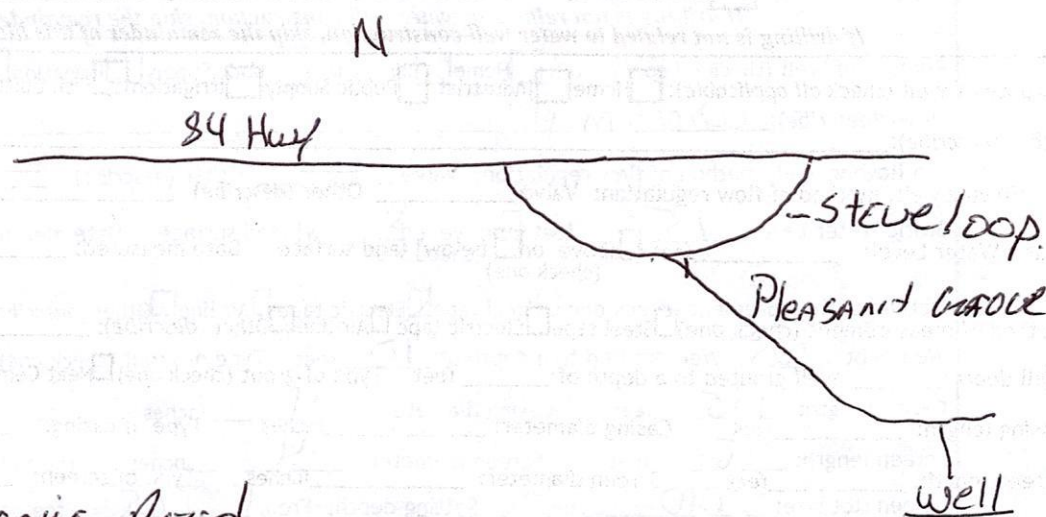

Landowner Name: BYRNIE DEED

I HEREBY CERTIFY that the well/borehole was drilled, constructed, and completed in accordance with all applicable requirements of the Mississippi Department of Environmental Quality and the Mississippi Department of Health regulations, if applicable, and state laws.

Michael Kees 7737 4-1-19 [Signature]
 Print Name of Responsible Licensee and License No. Date Signature of Licensee