

Lincoln  
 N 2000  
 8-18-74

MISSISSIPPI  
 BOARD OF WATER COMMISSIONERS  
 416 North State Street  
 Jackson, Mississippi 39201

WATER WELL DRILLERS LOG

August 18 19 74 Grenn Water Well Cont. Lincoln  
 date well completed firm name county well located

LANDOWNER: D. E. Joyce  
 Route 4, Box 238  
 Brookhaven, Miss.  
 (mailing address)

description of formations encountered	from	to
Citronelle	0	00

WELL LOCATION:  
 sec. 20 T 6 N R 9 E 13U  
 8 miles SE of Brookhaven  
 (distance) (direction) (nearest town)

WELL PURPOSE: home  
 (home, irrigation, municipal, industrial)

WELL COMPLETION DATA:


- (1) diameter (inches) 6"
- (2) total depth (feet) 90'
- (3) static water level (feet) 60' below top of ground
- (4) casing PVC 84'  
 (material) (depth)  
 4" If telescope see back.  
 (size)
- (5) screen 6' 84'  
 (length) (depth to top)  
 .010 PVC  
 (size) (material)
- (6) pump did not install  
 (HP) (yield gpm)  
 (type power)
- (7) electric log no  
 (yes or no)  
 (organization running log)
- (8) how well bottom plugged wood

DRILLERS REMARKS:

MISSISSIPPI BOARD OF WATER COMMISSIONERS  
 JACKSON, MISSISSIPPI

If well telescopes please sketch and show depths.

GROUND LEVEL

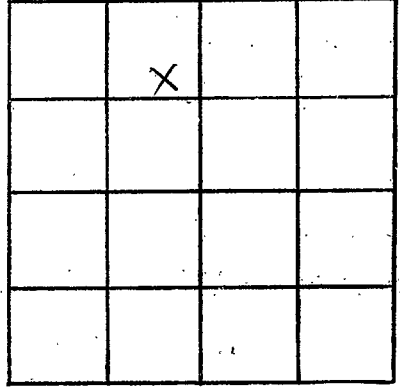

SECTION 20

Please indicate well location X.

ADDITIONAL INFORMATION

If more than one screen, show locations of each on sketch.