

Lincoln
 N 2001
 8-19-75

MISSISSIPPI
 BOARD OF WATER COMMISSIONERS
 416 North State Street
 Jackson, Mississippi 39201

WATER WELL DRILLERS LOG


Aug. 19 75 Gremm Water Well Lincoln
 date well completed firm name county well located

LANDOWNER: Gerald Hewitt Route 4	description of formations encountered Citronelle	from 0	to 72
Brookhaven, Miss. (mailing address)			
WELL LOCATION: sec. 8 T 6X N R 9 E 13Y 6 miles SE of Brookhaven (distance) (direction) (nearest town)			
WELL PURPOSE: home (home, irrigation, municipal, industrial)			
WELL COMPLETION DATA: (1) diameter (inches) 6" (2) total depth (feet) 72' (3) static water level (feet) 48 below above top of ground. (4) casing PVC 66 (material) (depth) 4" (size) if telescope see back. (5) screen 6' 66' (length) (depth to top) .010 PVC (size) (material) (6) pump 1/3 Sub 7 (HP) (yield gpm) Electric (type power) (7) electric log no (yes or no) (organization running log) (8) how well bottom plugged wood			
DRILLERS REMARKS:			

MISSISSIPPI BOARD OF WATER COMMISSIONERS
 JUNE 1975
 MISSISSIPPI BOARD OF WATER COMMISSIONERS

If well telescopes please sketch and show depths.

GROUND LEVEL

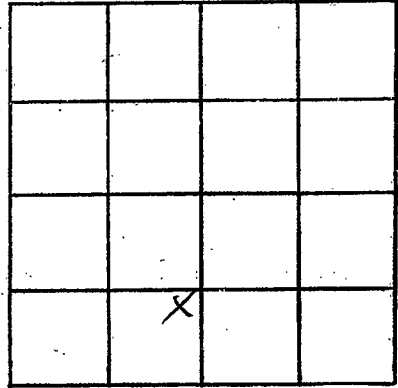

SECTION 8

Please indicate well location X.

ADDITIONAL INFORMATION

If more than one screen, show locations of each on sketch.