

Lincoln
N 2002
9-18-75

MISSISSIPPI
 BOARD OF WATER COMMISSIONERS
 416 North State Street
 Jackson, Mississippi 39201

WATER WELL DRILLERS LOG

Sept. 18 1975 Grenn Water Well Lincoln
 date well completed firm name county well located

LANDOWNER: Mickey Cooper
205 Barksdale
 description of formations encountered from to
citronelle 0 106

Brookhaven, Miss.
 (mailing address)

WELL LOCATION:
 sec. 9 T 6 N R. 9 E ^{13V}
10 miles SE of Brookhaven
 (distance) (direction) (nearest town)

WELL PURPOSE: home
 (home, irrigation, municipal, industrial)


- WELL COMPLETION DATA:
- (1) diameter (inches) 4
 - (2) total depth (feet) 106
 - (3) static water level (feet) 80 below above top of ground.
 - (4) casing PVC 100
 (material) (depth)
4"
 (size) if telescope see back.
 - (5) screen 6' 100'
 (length) (depth to top)
.010 PVC
 (size) (material)
 - (6) pump 1/3 Sub 7
 (HP) (yield gpm)
electric
 (type power)
 - (7) electric log no
 (yes or no)
 (organization running log)
 - (8) how well bottom plugged wood

DRILLERS REMARKS:

MISSISSIPPI BOARD OF WATER COMMISSIONERS
 JUNE 13 1976
 MISS: 22 OF WATER COMMISSIONERS

If well telescopes please sketch and show depths.

GROUND LEVEL

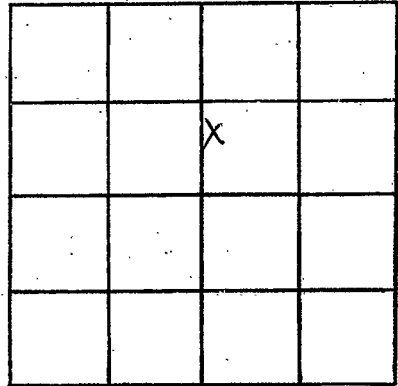

SECTION 9

Please indicate well location X.

ADDITIONAL INFORMATION

If more than one screen, show locations of each on sketch.