

LINCOLN
N 2004
12-10-75

MISSISSIPPI
 BOARD OF WATER COMMISSIONERS
 416 North State Street
 130 Jackson, Mississippi 39201

WATER WELL DRILLERS LOG


Dec 10 1975 Reuss Well Services Lincoln
 date well completed firm name county well located

LANDOWNER:	description of formations encountered	from	to
<u>Mr. Glen Keyzar</u> <u>Rt. Brookhaven</u> (mailing address)	<u>Red clay</u> <u>Red sand</u> <u>per ground level</u>	<u>0</u> <u>12</u> <u>90</u>	<u>12</u> <u>90</u> <u>100</u>
WELL LOCATION: sec. <u>22</u> T- <u>6</u> N R- <u>9</u> E <u>10</u> miles <u>S-SE</u> of <u>Brookhaven</u> (distance) (direction) (nearest town)			
WELL PURPOSE: <u>Home</u> (home, irrigation, municipal, industrial)			
WELL COMPLETION DATA:			
(1) diameter (inches) <u>4 1/2"</u>			
(2) total depth (feet) <u>100</u>			
(3) static water level (feet) <u>59</u> <u>above</u> below top of ground.			
(4) casing <u>plastic, bottom</u> (material) (depth) <u>1</u> if telescope see back. (size)			
(5) screen <u>6'</u> <u>9 1/2"</u> (length) (depth to top)			
<u>4 1/2"</u> <u>plastic</u> (size) (material)			
(6) pump <u>old pump brother</u> (HP) (yield gpm) <u>elist</u> (type power)			
(7) electric log <u>NO</u> (yes or no)			
(organization running log)			
(8) how well bottom plugged <u>wooden plug</u>			
DRILLERS REMARKS: <u>No. location</u>			

RECEIVED
 MAR 8 1976

If well telescopes please sketch and show depths.

GROUND LEVEL

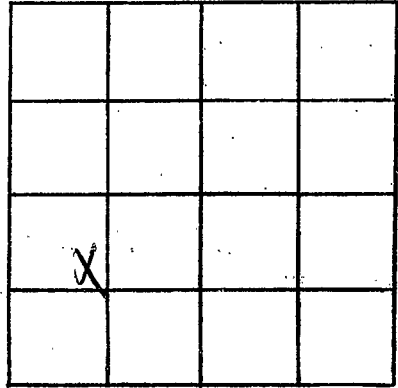

SECTION 25

Please indicate well location X.

ADDITIONAL INFORMATION

If more than one screen, show locations of each on sketch.