

Lincoln
 N 2005
 9-13-76

MISSISSIPPI
 BOARD OF WATER COMMISSIONERS
 416 North State Street
 Jackson, Mississippi 39201

WATER WELL DRILLERS LOG

Sept 13 1976 *Reems Well Co* Lincoln
 date well completed firm name county well located


LANDOWNER:	description of formations encountered	from	to
<i>Melond Burris</i>			
<i>At Monticello</i> (mailing address)	<i>Red Clay</i>	<i>0</i>	<i>17</i>
	<i>Red sand</i>	<i>17</i>	<i>42</i>
	<i>Red gravel sand</i>	<i>42</i>	<i>65</i>
WELL LOCATION:			
sec. <i>14</i> T. <i>6</i> N R. <i>9</i> E			
<i>2 1/2</i> miles <i>E</i> of <i>East Lincoln</i>			
(distance) (direction) (nearest town)			
WELL PURPOSE: <i>Home</i>			
(home, irrigation, municipal, industrial)			
WELL COMPLETION DATA:			
(1) diameter (inches) <i>4"</i>			
(2) total depth (feet) <i>65</i>			
(3) static water level (feet) <i>55</i> below top of ground.			
(4) casing <i>plastic, bottom</i> (material) (depth)			
<i>6'</i> If telescope see back. (size)			
(5) screen <i>59'</i> (length) (depth to top)			
<i>4"</i> <i>plastic</i> (size) (material)			
(6) pump <i>hyathus</i> (HP) (yield.gpm)			
<i>shot</i> (type power)			
(7) electric log <i>no</i> (yes or no)			
<i>no</i> (organization running log)			
(8) how well bottom plugged <i>completely</i>			
DRILLERS REMARKS:			

RECEIVED
 NOV 15 1976

MISS. BD. OF WATER COMMISSIONERS

If well telescopes please sketch and show depths.

GROUND LEVEL

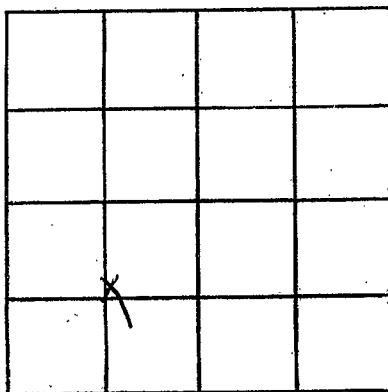

SECTION 14

Please indicate well location X.

ADDITIONAL INFORMATION

If more than one screen, show locations of each on sketch.