

Lincoln
N 2006
1-15-76

134

MISSISSIPPI
 BOARD OF WATER COMMISSIONERS
 416 North State Street
 Jackson, Mississippi 39201

WATER WELL DRILLERS LOG

Jan 15 1976 Grenn Water Well Con. Lincoln
 date well completed firm name county well located

LANDOWNER:
 Daniel Barrilleaux
 Route 1, Box 136E
 Bogue Chitto, Miss.
 (mailing address)

description of formations encountered
 Citronelle from 1 to 86

WELL LOCATION:
 sec. 31 T. 6 N R. 9 E
 9 miles SE of Brookhaven
 (distance) (direction) (nearest town)

WELL PURPOSE: home
 (home, irrigation, municipal, industrial)

WELL COMPLETION DATA:

(1) diameter (inches) 4

(2) total depth (feet) 86

(3) static water level (feet) 45 below top of ground

(4) casing PVC 80
 (material) (depth)
 4" (size) if telescope see back.

(5) screen 6' 80'
 (length) (depth to top)
 .010 PVC
 (size) (material)

(6) pump did not install
 (HP) (yield gpm)

(type power)

(7) electric log no
 (yes or no)

(organization running log)


(8) how well bottom plugged wood

DECEMBER 1976
 MISSISSIPPI
 7 1976

DRILLERS REMARKS:
 MISS. Bd. OF WATER COM. 1976

If well telescopes please sketch and show depths.

GROUND LEVEL

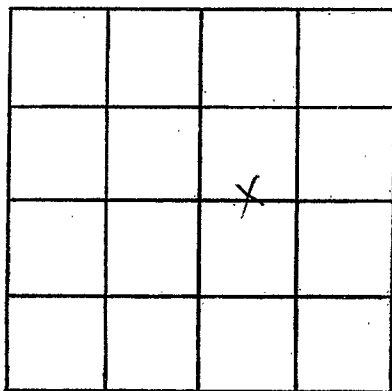

SECTION 31

Please indicate well location X.

ADDITIONAL INFORMATION

If more than one screen,
show locations of each on sketch.