

Lincoln
 N 2008
 3-25-77

MISSISSIPPI
 BOARD OF WATER COMMISSIONERS
 416 North State Street
 132 Jackson, Mississippi 39201

WATER WELL DRILLERS LOG

March 25 19 77 Grenn Water Well Cont... Lincoln
 date well completed firm name county well located


LANDOWNER: Buddy Moak	description of formations encountered	from	to
Route 1			
Ruth, Miss. (mailing address)			
WELL LOCATION:			
sec. 29 T 6 N R 9 E S W			
9 miles E of Bogue Citto (distance) (direction) (nearest town)			
WELL PURPOSE: home (home, irrigation, municipal, industrial)			
WELL COMPLETION DATA:			
(1) diameter (inches) 6			
(2) total depth (feet) 122			
(3) static water level (feet) 50 below top of ground.			
(4) casing PVC 116 (material) (depth)			
4" If telescope see back. (size)			
(5) screen 6' 116' (length) (depth to top)			
.010 PVC (size) (material)			
(6) pump did not install (HP) (yield gpm)			
(type power)			
(7) electric log no (yes or no)			
(organization running log)			
(8) how well bottom plugged back wash valve			
DRILLERS REMARKS:			

RECEIVED
 APR 22 1977

MISS. BD. OF WATER COMM.

If well telescopes please sketch and show depths.

GROUND LEVEL

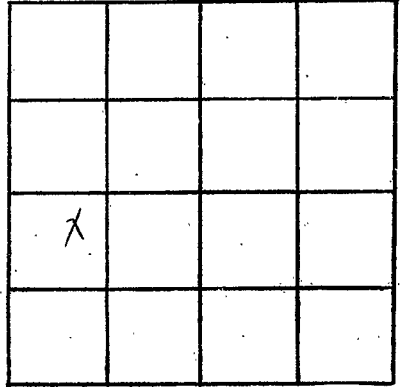

SECTION 29

Please indicate well location X.

ADDITIONAL INFORMATION

If more than one screen,
show locations of each on sketch.