

Lincoln
N 2009
4-7-77

MISSISSIPPI
 BOARD OF WATER COMMISSIONERS
 416 North State Street
 Jackson, Mississippi 39201

WATER WELL DRILLERS LOG

April 7 1977 Grenn Water Well Cont. Lincoln
 date well completed firm name county well located


LANDOWNER: George D. Butler, Jr. Route 1, Box 126 Brookhaven, Miss. (mailing address)	description of formations encountered Citonelle	from 1	to 87
WELL LOCATION:			
sec. <u>2</u> T. <u>6</u> N R. <u>9</u> E <div style="margin-left: 100px;"> --- <u>5</u> W </div> <u>11</u> miles SE of Brookhaven (distance) (direction) (nearest town)			
WELL PURPOSE: home (home, irrigation, municipal, industrial)			
WELL COMPLETION DATA:			
(1) diameter (inches) <u>6</u>			
(2) total depth (feet) <u>87</u>			
(3) static water level (feet) <u>67</u> below top of ground. above			
(4) casing <u>PVC</u> <u>75</u> (material) (depth) <u>4"</u> (size) if telescope see back.			
(5) screen <u>1/2"</u> <u>75"</u> (length) (depth to top) <u>.010</u> <u>PVC</u> (size) (material)			
(6) pump <u>1/2</u> sub <u>10</u> (HP) (yield gpm) <u>electricity</u> (type power)			
(7) electric log <u>no</u> (yes or no) (organization running log)			
(8) how well bottom plugged <u>backwash valve</u>			
DRILLERS REMARKS:			

RECEIVED
 JUN 14 1977

MISS. BD. OF WATER COMMISSIONERS

If well telescopes please sketch and show depths.

GROUND LEVEL

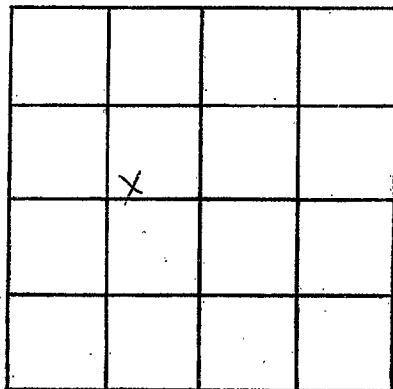

SECTION 2

Please indicate well location X.

ADDITIONAL INFORMATION

If more than one screen, show locations of each on sketch.