

Lincoln
N 2011
July 15, 1977

MISSISSIPPI
 BOARD OF WATER COMMISSIONERS
 416 North State Street
 130 Jackson, Mississippi 39201

WATER WELL DRILLERS LOG

July 15 1977 Grenn Water Well Cont. Lincoln
 date well completed firm name county well located

LANDOWNER:
 T.J. Bessonette
 Route 4
 Brookhaven, Miss.
 (mailing address)

description of fomations encountered	from	to
Citronelle	1	98

WELL LOCATION:
 sec. 29 T 6 N R 9 E
 -S- -W-
 10 miles E of Bogue Chitto
 (distance) (direction) (nearest town)

WELL PURPOSE: home
 (home, irrigation, municipal, industrial)

WELL COMPLETION DATA:

(1) diameter (inches) 6

(2) total depth (feet) 98

(3) static water level (feet) 40 below above top of ground.

(4) casing PVC 86
 (material) (depth)
 4" If telescope see back.
 (size)

(5) screen 12' 86'
 (length) (depth to top)
 .010 PVC
 (size) (material)

(6) pump 1/2 HP sub 10
 (HP) (yield gpm)
 electricity
 (type power)

(7) electric log no
 (yes or no)

(organization running log)

(8) how well bottom plugged back wash valve

DRILLERS REMARKS:


RECEIVED

AUG 4 1977

MISS. BD. OF WATER COMMISSIONERS

If well telescopes please sketch and show depths.

GROUND LEVEL

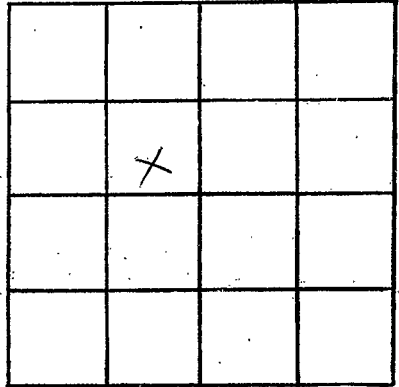

SECTION 29

Please indicate well location X.

ADDITIONAL INFORMATION

If more than one screen,
show locations of each on sketch.