

Lincoln
 N 2012
 July 26, 1977

MISSISSIPPI
 BOARD OF WATER COMMISSIONERS
 416 North State Street
 137 Jackson, Mississippi 39201
 WATER WELL DRILLERS LOG

July 26 1977 Gren Water Well Cont. Lincoln
 date well completed firm name county well located

LANDOWNER: James McDonald
 Route 4
 Brookhaven, Miss.
 (mailing address)

description of formations encountered	from	to
Citronelle	1	85

WELL LOCATION:
 sec. 7 T. 6 N R. 9 E
 S V
 7 miles SE of Brookhaven
 (distance) (direction) (nearest town)

WELL PURPOSE: home
 (home, irrigation, municipal, industrial)

WELL COMPLETION DATA:
 (1) diameter (inches) 6
 (2) total depth (feet) 85
 (3) static water level (feet) 55 below top of ground.
 (4) casing PVC 73', 4" (material) (depth) (size) If telescope see back.
 (5) screen 12' 73' (length) (depth to top)
 .010 PVC (size) (material)
 (6) pump 3/4 HP sub 10 (HP) (yield gpm)
 electricity (type power)
 (7) electric log no (yes or no)
 (organization running log)

(8) how well bottom plugged back wash valve

DRILLERS REMARKS:


RECEIVED

AUG 21 1977

MISS. BD. OF WATER COMM

If well telescopes please sketch and show depths.

GROUND LEVEL

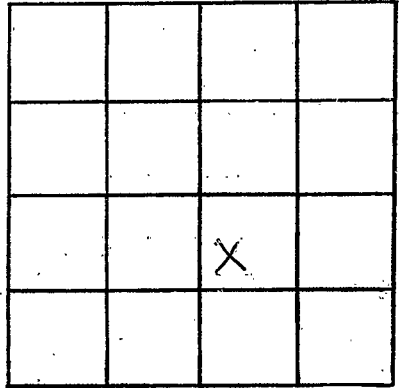

SECTION 7

Please indicate well location X.

ADDITIONAL INFORMATION

If more than one screen, show locations of each on sketch.