

LINCOLN
N 2013
2/16/78

MISSISSIPPI
BOARD OF WATER COMMISSIONERS
416 North State Street
Jackson, Mississippi 39201

WATER WELL DRILLERS LOG

Feb. 16 1978 Grenn Water Well Cont. Lincoln
date well completed firm name county well located

LANDOWNER: Jeanette Fuller		description of formations encountered	from	to
Route 4, Box 254				
Brookhaven, Miss. (mailing address)		Citronelle k		
WELL LOCATION: sec. 22 T 6 N R 9 E -S- W- 11 miles SE of Brookhaven (distance) (direction) (nearest town)				
WELL PURPOSE: home (home, irrigation, municipal, industrial)				
WELL COMPLETION DATA:				
(1) diameter (inches) 6				
(2) total depth (feet) 100				
(3) static water level (feet) 50 below top of ground. above				
(4) casing PVC 88 (material) (depth) 4" if telescope see back. (size)				
(5) screen 12' 88' (length) (depth to top) .010 PVC (size) (material)				
(6) pump 1/2 sub 10 (HP) (yield gpm) electricity (type power)				
(7) electric log no (yes or no) (organization running log)				
(8) how well bottom plugged backwash valve				
DRILLERS REMARKS:				


RECEIVED

FEB 27 1978

MISS. BOARD OF WATER COMM

If well telescopes please sketch and show depths.

GROUND LEVEL

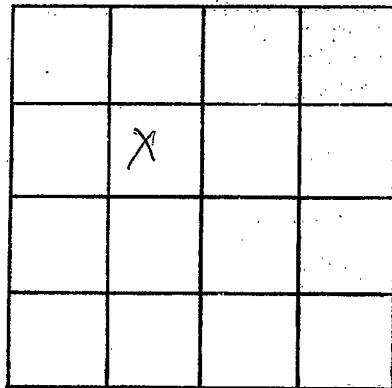

SECTION 22

Please indicate well location X.

ADDITIONAL INFORMATION

A series of horizontal lines for writing additional information, starting below the 'ADDITIONAL INFORMATION' header and extending down to the bottom of the page.

If more than one screen, show locations of each on sketch.