

LINCOLN

N 2014

3/4/78

MISSISSIPPI BOARD OF WATER COMMISSIONERS
416 North State Street
Jackson, Mississippi 39201

WATER WELL DRILLERS LOG

3-4 1978 Grenn Water Well Contractor Lincoln
date well completed firm name county well located


LANDOWNER:	description of fomations encountered	from	to
David M. Thames	Clay	1	20
Route 4, Box 206	Sand & Gravel	20	83
Brookhaven, Miss.	White clay	83	103
(mailing address)	Blue Clay	103	190
WELL LOCATION:	White clay	190	195
sec. 14 T. 6 N R. 9 E	sand	195	243
S -- -- W -			
11 miles SE of Brookhaven			
(distance) (direction) (nearest town)			
WELL PURPOSE: home			
(home, irrigation, municipal, industrial)			
WELL COMPLETION DATA:			
(1) diameter (inches) 6			
(2) total depth (feet) 243			
(3) static water level (feet) 100 below top of ground.			
(4) casing PVC 231 (material), (depth)			
4" (size) if telescope see back.			
(5) screen 12' 231' (length), (depth to top)			
.010 PVC (size), (material)			
(6) pump 1 HP sub 10 (HP) (yield gpm)			
electricity (type power)			
(7) electric log no (yes or no)			
(organization running log)			
(8) how well bottom plugged backwash valve			
DRILLERS REMARKS:			

RECEIVED
APR 17 1978

MISS. Bd. OF WATER COMM.

If well telescopes please sketch and show depths.

GROUND LEVEL

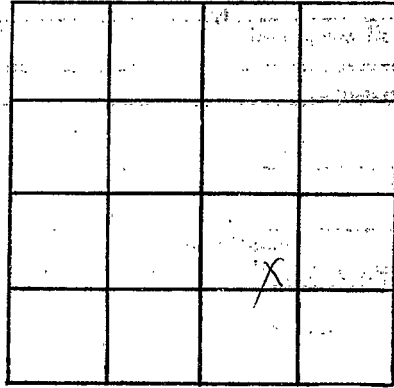

SECTION 14

Please indicate well location X.

ADDITIONAL INFORMATION

If more than one screen, show locations of each on sketch.