

LINCOLN
N
3/21/78
2015

MISSISSIPPI
 BOARD OF WATER COMMISSIONERS
 416 North State Street
 Jackson, Mississippi 39201

WATER WELL DRILLERS LOG


March 21 1978 Grenn Water Well Contractor Lincoln
 date well completed firm name county well located

LANDOWNER: Buryce Hall	description of formations encountered	from	to
Route 4			
Brookhaven, Miss. (mailing address)			
WELL LOCATION:			
sec. 9 T 6 N R 9 E --S-- --W--			
12 miles SE of Brookhaven (distance) (direction) (nearest town)			
WELL PURPOSE: home (home, irrigation, municipal, industrial)			
WELL COMPLETION DATA:			
(1) diameter (inches) 6			
(2) total depth (feet) 78			
(3) static water level (feet) 45 below top of ground.			
(4) casing PVC 72 (material) (depth)			
4" If telescope see back. (size)			
(5) screen 6' 72' (length) (depth to top)			
.010 PVC (size) (material)			
(6) pump did not install (HP) (yield gpm)			
(type power)			
(7) electric log no (yes or no)			
(organization running log)			
(8) how well bottom plugged back wash valve			
DRILLERS REMARKS:			

RECEIVED
 APR 17 1978
 MISS. BD. OF WATER COM.

If well telescopes please sketch and show depths.

GROUND LEVEL

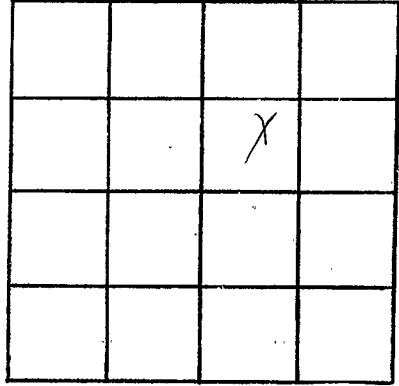

SECTION 9

Please indicate well location X.

ADDITIONAL INFORMATION

If more than one screen,
show locations of each on sketch.