

LINCOLN
N
4/7/78
2016

**MISSISSIPPI  
BOARD OF WATER COMMISSIONERS**  
416 North State Street  
Jackson, Mississippi 39201  
**WATER WELL DRILLERS LOG**

April 7 1978 Grenn Water Well Cont. Lincoln  
 date well completed firm name county well located

**LANDOWNER:** Robert Shumaker  
 Route # 4  
 Brookhaven, Miss.  
 (mailing address)

description of formations encountered	from	to
Clay	1	60
Sand & Gravel	60	110

**WELL LOCATION:**  
 sec. 1 T. 6N R. 9 E  
 -S -W-  
 10 miles SE of Brookhaven  
 (distance) (direction) (nearest town)

**WELL PURPOSE:** home  
 (home, irrigation, municipal, industrial)


- WELL COMPLETION DATA:**
- (1) diameter (inches) 6
  - (2) total depth (feet) 110
  - (3) static water level (feet) 0 below top of ground.
  - (4) casing PVC, 104' (material), (depth)  
 4" (size) if telescope see back.
  - (5) screen 6' 104' (length), (depth to top)  
 .010 PVC (size), (material)
  - (6) pump 1/2 HP sub 10 (HP), (yield gpm)  
 electricity (type power)
  - (7) electric log no (yes or no)  
 (organization running log)
  - (8) how well bottom plugged backwash valve

**DRILLERS REMARKS:**

**RECEIVED**  
 APR 17 1978  
 MISS. BD. OF WATER COM. INT.

If well telescopes please sketch and show depths.

GROUND LEVEL

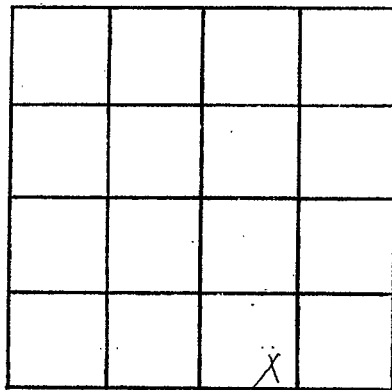

SECTION 1

Please indicate well location X.

ADDITIONAL INFORMATION

Lined area for additional information.

If more than one screen, show locations of each on sketch.