

Lincoln  
 N 2018  
 9-27/77

MISSISSIPPI  
 BOARD OF WATER COMMISSIONERS  
 416 North State Street  
 Jackson, Mississippi 39201

WATER WELL DRILLERS LOG

Sept. 27 1977 Grenn Water Well Cont. Lincoln  
 date well completed firm name county well located


LANDOWNER:	description of formations encountered	from	to
John Paul Holmes Route 1 Ruth, Miss. (mailing address)	Citronelle	1	121
WELL LOCATION: sec. 34 T 6 N R 9 E 10 miles SE of Brookhaven (distance) (direction) (nearest town)			
WELL PURPOSE: home (home, irrigation, municipal, industrial)			
WELL COMPLETION DATA: (1) diameter (inches) 6 (2) total depth (feet) 121 (3) static water level (feet) 70 below above top of ground. (4) casing PVC 115' (material) (depth) 4" if telescope see back. (size) (5) screen 6' 115' (length) (depth to top) .010 PVC (size) (material) (6) pump 3/4 sub 10 (HP) (yield gpm) electricity (type power) (7) electric log no (yes or no) (organization running log)			
(8) how well bottom plugged back wash valve			
DRILLERS REMARKS:			

RECEIVED  
 OCT 22 1977

MISS. BD. OF WATER COMMISSIONERS

If well telescopes please sketch and show depths.

GROUND LEVEL

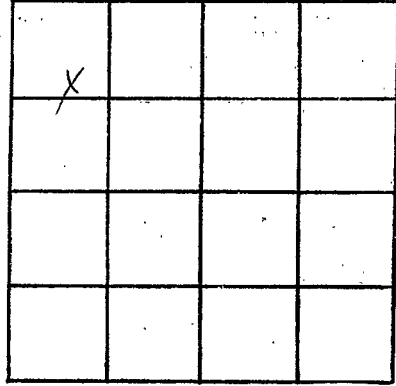

SECTION 34

Please indicate well location X.

ADDITIONAL INFORMATION

If more than one screen, show locations of each on sketch.