

LINCOLN
N <u>2020</u>
2-15-79

**MISSISSIPPI
BOARD OF WATER COMMISSIONERS**
416 North State Street
Jackson, Mississippi 39201

WATER WELL DRILLERS LOG

Feb. 15 1979 Grenn Water Well Cont. Lincoln
 date well completed firm name county well located

LANDOWNER: Clifford Galey
 Route 1, Box 332 DD
 LaCombe, La. 70445
 (mailing address)

description of formations encountered	from	to
Citronelle	1	104

WELL LOCATION:
 sec. 23 T. 6 N R. 9 E
 S W
 11 miles E of Bogue Chitto
 (distance) (direction) (nearest town)

WELL PURPOSE: home
 (home, irrigation, municipal, industrial)

- WELL COMPLETION DATA:**
- (1) diameter (inches) 6 4
 - (2) total depth (feet) 104
 - (3) static water level (feet) 80 below
 top of ground. above
 - (4) casing PVC 92
 (material) (depth)
4"
 (size) if telescope see back.
 - (5) screen 12' 92'
 (length) (depth to top)
.010 PVC
 (size) (material)
 - (6) pump did not install
 (HP) (yield gpm)
 - (type power)
 - (7) electric log no
 (yes or no)
 - (organization running log)
 - (8) how well bottom plugged
backwash valve

DRILLERS REMARKS:


Miss. Board of Water Comm.

MAR 9 - 1979

RECEIVED

If well telescopes please sketch and show depths.

GROUND LEVEL

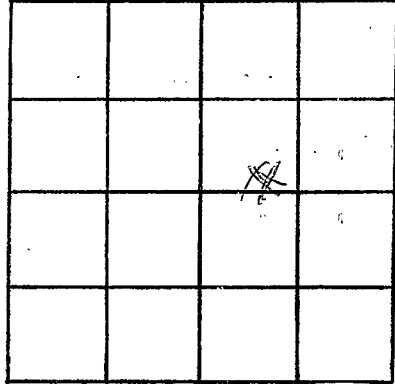

SECTION 2.3

Please indicate well location X.

ADDITIONAL INFORMATION

Lined area for additional information.

If more than one screen, show locations of each on sketch.