

Lincoln  
N  
2023  
5-13-79

MISSISSIPPI  
BOARD OF WATER COMMISSIONERS  
416 North State Street  
Jackson, Mississippi 39201

WATER WELL DRILLERS LOG

May 13 1979 Rever Well Services Lincoln  
date well completed firm name county well located

LANDOWNER:	description of formations encountered	from	to
Bobby Dale Ruby Rt 1 box 886, Ruth (mailing address)			
WELL LOCATION:			
sec <u>18</u> T <u>6</u> N R <u>9</u> E 11 miles <u>E. SE</u> of <u>Brookhaven</u> (distance) (direction) (nearest town)			
WELL PURPOSE: <u>Trailer</u> (home, irrigation, municipal, industrial)			
WELL COMPLETION DATA:			
(1) diameter (inches) <u>4"</u>			
(2) total depth (feet) <u>90</u>			
(3) static water level (feet) <u>62</u> below top of ground.			
(4) casing <u>plastic, cotton</u> (material) (depth)			
<u>      </u> If telescope see back. (size)			
(5) screen <u>5'</u> <u>85'</u> (length) (depth to top)			
<u>4"</u> <u>plastic</u> (size) (material)			
(6) pump <u>2 1/2</u> <u>10</u> (HP) (yield gpm)			
<u>split</u> (type power)			
(7) electric log <u>NO</u> (yes or no)			
<u>      </u> (organization running log)			
(8) how well bottom plugged <u>Washed</u>			
DRILLERS REMARKS:			


DEPT. OF NATURAL RESOURCES  
BUREAU OF LAND & WATER RESOURCES

OCT 19 1979

RECEIVED

If well telescopes please sketch and show depths.

GROUND LEVEL

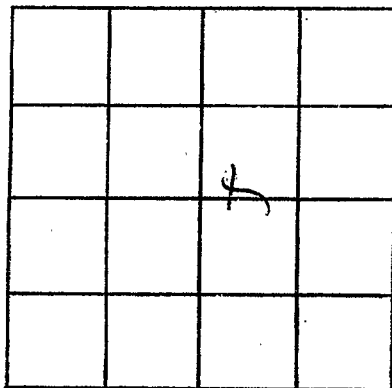

SECTION 18

Please indicate well location X.

ADDITIONAL INFORMATION

If more than one screen, show locations of each on sketch.