

Lincoln
 N 2024
 7-21-79

MISSISSIPPI
 BOARD OF WATER COMMISSIONERS
 416 North State Street
 Jackson, Mississippi 39201

WATER WELL DRILLERS LOG

July 21 1979 Reams well ser Lincoln
 date well completed firm name county well located

LANDOWNER:
 Jessie Delaughter
 Rt 4 Brookhaven
 (mailing address)

description of formations encountered	from	to
Clay	0	17
Red sand	17	55
sand & gravel	55	68
blue chalk	68	190
plc gravel & sand	190	205

WELL LOCATION:
 sec. 5 T-6 N R-9 E
 7 miles S-SE of Brookhaven
 (distance) (direction) (nearest town)

WELL PURPOSE: home
 (home, irrigation, municipal, industrial)

WELL COMPLETION DATA:

(1) diameter (inches) 4"

(2) total depth (feet) 205

(3) static water level (feet) 90' below top of ground.

(4) casing plastic bottom
 (material) (depth)

(size) If telescope see back.

(5) screen 10' ϕ 95"
 (length) (depth to top)

4" plastic
 (size) (material)

(6) pump by others
 (HP) (yield gpm)

elct
 (type power)

(7) electric log NO
 (yes or no)

(organization running log)

(8) how well bottom plugged
 wooden plug

DRILLERS REMARKS:


DEPT. OF NATURAL RESOURCES
 BUREAU OF LAND & WATER RESOURCES

MAR 5 - 1980

RECEIVED

If well telescopes please sketch and show depths.

GROUND LEVEL

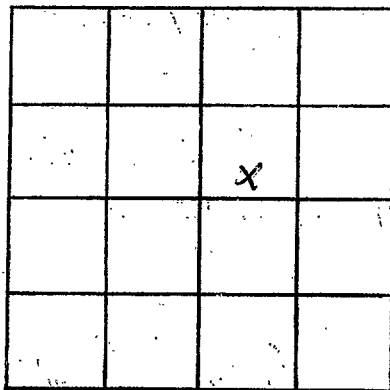

SECTION 5

Please indicate well location X.

ADDITIONAL INFORMATION

If more than one screen, show locations of each on sketch.