

Lincoln

N 2025

5/12/80

May 13

MISSISSIPPI  
 BOARD OF WATER COMMISSIONERS  
 416 North State Street  
 Jackson, Mississippi 39201

WATER WELL DRILLERS LOG

80 Grenn Water Well Cont. Lincoln

date well completed

firm name

county well located

LANDOWNER:

Ruben Johnson

Route 4, Box 16 A  
Brookhaven, Miss.

(mailing address)

description of formations encountered

Citronelle

from

1

to

100

WELL LOCATION:

sec. 11 T 6 (N) R 9 E  
S W

7 miles S.E. of Brookhaven  
(distance) (direction) (nearest town)

WELL PURPOSE:

home  
(home, irrigation, municipal, industrial)

WELL COMPLETION DATA:

- (1) diameter (inches) 4
- (2) total depth (feet) 100
- (3) static water level (feet) 66 below top of ground.
- (4) casing PVC 90' (material), (depth)  
4" (size) if telescope see back.
- (5) screen 10' 90' (length), (depth to top)  
.010 PVC (size), (material)
- (6) pump did not install (HP), (yield gpm)  
(type power)
- (7) electric log no (yes or no)  
(organization running log)
- (8) how well bottom plugged back wash valve


DRILLERS REMARKS:

DEPT OF NATURAL RESOURCES  
BUREAU OF LAND & WATER RESOURCES

JUN 20 1980  
RECEIVED

If well telescopes please sketch and show depths.

**GROUND LEVEL**

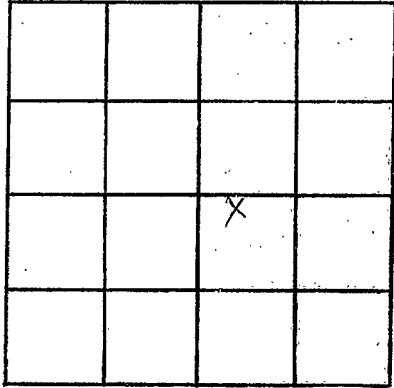

SECTION 21

Please indicate well location X.

**ADDITIONAL INFORMATION**

If more than one screen, show locations of each on sketch.