

Lincoln  
 N 2028  
 8/12/80

MISSISSIPPI  
 BOARD OF WATER COMMISSIONERS  
 416 North State Street  
 Jackson, Mississippi 39201

WATER WELL DRILLERS LOG

Aug. 12 1980 Grenn Water Well Cont. Lincoln

date well completed firm name county well located

LANDOWNER:	description of formations encountered	from	to
William C. Calhoun c/o G & M Milling Brookhaven, Ms. (mailing address)	Citronelle	1	65
<b>WELL LOCATION:</b>			
sec. 7 T. 6 N R. 9 E 7 SE Brookhaven (distance) miles (direction) of (nearest town)			
<b>WELL PURPOSE:</b> home (home, irrigation, municipal, industrial)			
<b>WELL COMPLETION DATA:</b>			
(1) diameter (inches) 4			
(2) total depth (feet) 65			
(3) static water level (feet) 45 below top of ground.			
(4) casing PVC 55' (material) (depth) 4" (size) if telescope see back.			
(5) screen 10' 55' (length) (depth to top) .010 PVC (size) (material)			
(6) pump 1/2 sub 8 (HP) (yield gpm) electricity (type power)			
(7) electric log no (yes or no) (organization running log)			
(8) how well bottom plugged back wash valve			
DRILLERS REMARKS:			


DEPT. OF NATURAL RESOURCES  
 BUREAU OF LAND & WATER RESOURCES

OCT 23 1980

RECEIVED

If well telescopes please sketch and show depths.

GROUND LEVEL

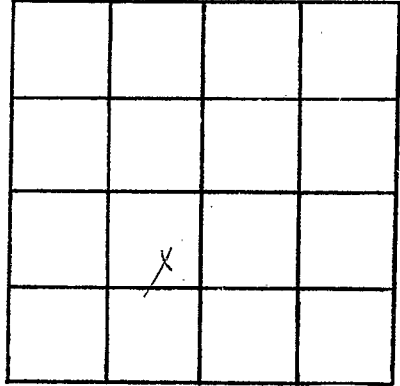

SECTION 7

Please indicate well location X.

ADDITIONAL INFORMATION

Lined area for additional information.

If more than one screen, show locations of each on sketch.