

Lincoln  
N 2029  
9-10-80

MISSISSIPPI  
BOARD OF WATER COMMISSIONERS  
416 North State Street  
Jackson, Mississippi 39201

WATER WELL DRILLERS LOG

Sept. 10 1980 Grenn Water Well Cont. Lincoln  
date well completed firm name county well located

LANDOWNER: James R. Goddard	description of formations encountered	from	to
Route 4	Citronelle	1	91
Brookhaven, Miss. (mailing address)			
<b>WELL LOCATION:</b> sec. 33 T. 6 <u>N</u> R. 9 <u>E</u> S W			
8 miles <u>E</u> of Bogue Chitto (distance) (direction) (nearest town)			
<b>WELL PURPOSE:</b> home (home, irrigation, municipal, industrial)			
<b>WELL COMPLETION DATA:</b>			
(1) diameter (inches) 4			
(2) total depth (feet) 91			
(3) static water level (feet) 45 below top of ground. above			
(4) casing PVC 81 (material) (depth) 4" If telescope see back. (size)			
(5) screen 10' 81' (length) (depth to top) .010 PVC (size) (material)			
(6) pump 1/2 sub 10 (HP) (yield gpm) electricity (type power)			
(7) electric log no (yes or no)  (organization running log)			
(8) how well bottom plugged backwash valve			
<b>DRILLERS REMARKS:</b>			


DEPT. OF NATURAL RESOURCES  
BUREAU OF LAND & WATER RESOURCES

OCT 23 1980

RECEIVED

If well telescopes please sketch and show depths.

GROUND LEVEL

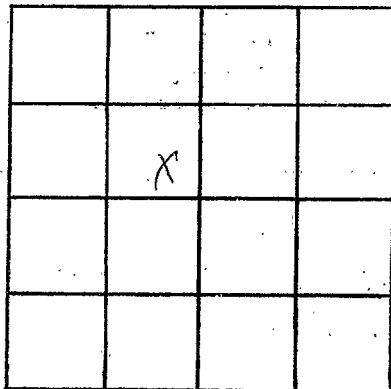

SECTION 33

Please indicate well location X.

ADDITIONAL INFORMATION

If more than one screen, show locations of each on sketch.