

Lincoln
N 2030
11-10-80

MISSISSIPPI
 BOARD OF WATER COMMISSIONERS
 416 North State Street
 Jackson, Mississippi 39201

WATER WELL DRILLERS LOG

Nov, 10 1980 Grenn Water Well Cont. Lincoln
 date well completed firm name county well located

LANDOWNER: Bill Searcy
Route 4
Brookhaven, Ms.
 (mailing address)

description of formations encountered	from	to
<u>Citronelle</u>	<u>1</u>	<u>100</u>

WELL LOCATION:
 sec. 18 T. 6 N R. 9 E
 S W
7 miles SE of Brookhaven
 (distance) (direction) (nearest town)

WELL PURPOSE: home
 (home, irrigation, municipal, industrial)

- WELL COMPLETION DATA:
- (1) diameter (inches) 4
 - (2) total depth (feet) 100
 - (3) static water level (feet) 60 below above top of ground.
 - (4) casing PVC 90
 (material) (depth)
4 1/2" if telescope see back.
 (size)
 - (5) screen 10' 90'
 (length) (depth to top)
.010 PVC
 (size) (material)
 - (6) pump 1/2 sub 8
 (HP) (yield gpm)
electricity
 (type power)
 - (7) electric log no
 (yes or no)

(organization running log)


(8) how well bottom plugged
back wash valve

DRILLERS REMARKS:

DEPT. OF NATURAL RESOURCES
 BUREAU OF LAND & WATER RESOURCES
 JAN 12 1981
 RECEIVED

If well telescopes please sketch and show depths.

GROUND LEVEL

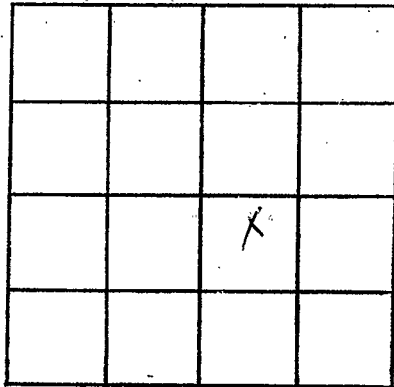

SECTION 18

Please indicate well location X.

ADDITIONAL INFORMATION

A series of horizontal lines for writing additional information, consisting of approximately 20 lines.

If more than one screen, show locations of each on sketch.