

**MISSISSIPPI DEPARTMENT OF NATURAL RESOURCES**  
**Bureau of Land and Water Resources**  
 Southport Mall  
 P.O. Box 10631  
 Jackson, Mississippi 39209  
**WATER WELL DRILLERS LOG**

Lincoln  
N 2032  
9-3-81

Sept. 3 1981 81 Grenn Water Well Cont. Lincoln  
 date well completed firm name county well located


LANDOWNER: <u>Meredith Woods</u>	description of formations encountered	from	to
<u>Rt 4, Box 228 1/2</u> <u>Brookhaven, Ms.</u>  (mailing address)			
<b>WELL LOCATION:</b> sec. <u>27</u> T. <u>6</u> <u>N</u> R. <u>9</u> <u>E</u> <u>10</u> miles <u>E</u> of <u>Bogue Chitto</u> (distance) (direction) (nearest town)			
<b>WELL PURPOSE:</b> <u>home</u> (home, irrigation, municipal, industrial)			
<b>WELL COMPLETION DATA:</b>			
(1) diameter (inches) <u>4</u>			
(2) total depth (feet) <u>125</u>			
(3) static water level (feet) <u>80</u> below above top of ground.			
(4) casing <u>PVC</u> <u>115</u> (material) (depth) <u>4"</u> (size) if telescope see back.			
(5) screen <u>10'</u> <u>115'</u> (length) (depth to top) <u>.010</u> <u>PVC</u> (size) (material)			
(6) pump <u>1/2</u> sub <u>8</u> (HP) (yield gpm) <u>electricity</u> (type power)			
(7) electric log <u>no</u> (yes or no)  (organization running log)			
(8) how well bottom plugged <u>back wash valve</u>			

DRILLERS REMARKS:  
 \_\_\_\_\_  
 \_\_\_\_\_

DEPT. OF NATURAL RESOURCES  
 BUREAU OF LAND & WATER RESOURCES  
 OCT 29 1981  
**RECEIVED**

If well telescopes please sketch and show depths.

GROUND LEVEL

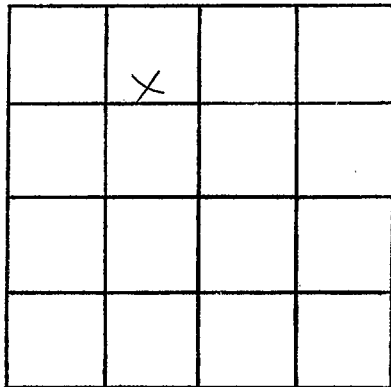

SECTION 29

Please indicate well location X.

ADDITIONAL INFORMATION

29  
A 9: 12

RECEIVED

If more than one screen, show locations of each on sketch.