

Lincoln
N 2033
9-18-81

MISSISSIPPI DEPARTMENT OF NATURAL RESOURCES
 Bureau of Land and Water Resources
 Southport Mall
 P.O. Box 10631
 Jackson, Mississippi 39209
WATER WELL DRILLERS LOG

Sept. 18 19 81 Grenn Water Well Cont. Lincoln
 date well completed firm name county well located

LANDOWNER: <u>Johnny Price</u>	description of formations encountered	from	to
<u>Route 1, Box 249 A</u> <u>Monticello, Ms.</u> (mailing address)			
WELL LOCATION: sec. <u>12</u> T. <u>6</u> N R. <u>9</u> E <u>12</u> miles <u>SE</u> of <u>Brookhaven</u> (distance) (direction) (nearest town)	Clay?	1	30
	sand & gravel	30	62
	white clay	62	90
	blue clay	90	105
	white clay	105	120
	sand	120	200
WELL PURPOSE: <u>home</u> (home, irrigation, municipal, industrial)			
WELL COMPLETION DATA:			
(1) diameter (inches) <u>4</u>			
(2) total depth (feet) <u>200</u>			
(3) static water level (feet) <u>105</u> below above top of ground.			
(4) casing <u>PVC</u> , <u>190'</u> (material), (depth) <u>4"</u> (size) if telescope see back.			
(5) screen <u>10'</u> , <u>190'</u> (length), (depth to top) <u>.010</u> , <u>PVC</u> (size), (material)			
(6) pump <u>3/4</u> sub <u>8</u> (HP) (yield gpm) <u>electricity</u> (type power)			
(7) electric log <u>no</u> (yes or no) <u>(organization, running log)</u>			
(8) how well bottom plugged <u>back wash valve</u>			

DEPT. OF NATURAL RESOURCES
 BUREAU OF LAND & WATER RESOURCES


OCT 29 1981

RECEIVED

DRILLERS REMARKS:

If well telescopes please sketch and show depths.

GROUND LEVEL

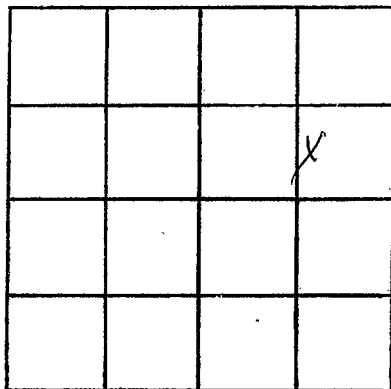

SECTION 12

Please indicate well location X.

ADDITIONAL INFORMATION

If more than one screen,
show locations of each on sketch.