

MISSISSIPPI DEPARTMENT OF NATURAL RESOURCES

Bureau of Land and Water Resources

Southport Mall

P.O. Box 10631

Jackson, Mississippi 39209

WATER WELL DRILLERS LOG

LINCOLN
N 234
6/22/81

Jan 22 1981 News Well Lincoln
date well completed firm name county well located


| LANDOWNER: | description of formations encountered | from | to |
|----------------------------------------------------------------------------------------------------------------------------------------------------|-----------------------------------------------|---------------|-----------------|
| Larry M.C. Brown Rt Ruth (mailing address) | Red sandy clay Red sand pea gravel sand | 0 27 80 | 27 80 102 |
| WELL LOCATION: sec. <u>34</u> T- <u>6</u> N R- <u>9</u> E <u>5</u> miles <u>N-NE</u> of <u>Ruth</u> (distance) (direction) (nearest town) | | | |
| WELL PURPOSE: <u>Trailer</u> (home, irrigation, municipal, industrial) | | | |
| WELL COMPLETION DATA: | | | |
| (1) diameter (inches) <u>4"</u> | | | |
| (2) total depth (feet) <u>102</u> | | | |
| (3) static water level (feet) <u>68</u> below above top of ground. | | | |
| (4) casing <u>plastic</u> <u>bottom</u> (material) (depth) | | | |
| _____ if telescope see back: (size) | | | |
| (5) screen <u>5'</u> <u>97'</u> (length) (depth to top) | | | |
| _____ <u>plastic</u> (size) (material) | | | |
| (6) pump <u>sub</u> <u>10</u> (HP) (yield gpm) | | | |
| _____ <u>West</u> (type power) | | | |
| (7) electric log <u>no</u> (yes or no) | | | |
| _____ <u>no</u> (organization running log) | | | |
| (8) how well bottom plugged <u>Back wash</u> | | | |
| DRILLERS REMARKS: _____ | | | |

DEPT. OF NATURAL RESOURCES
BUREAU OF LAND & WATER RESOURCES

JAN 4 - 1982
RECEIVED

If well telescopes please sketch and show depths.

GROUND LEVEL

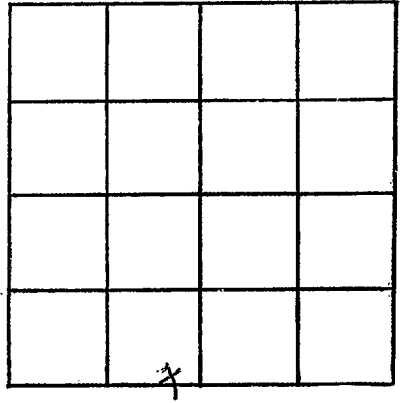

SECTION 34

Please indicate well location X.

ADDITIONAL INFORMATION

If more than one screen, show locations of each on sketch.