

Lincoln
N
2035

MISSISSIPPI DEPARTMENT OF NATURAL RESOURCES
 Bureau of Land and Water Resources
 Southport Mall
 P.O. Box 10631
 Jackson, Mississippi 39209
WATER WELL DRILLERS LOG

2/1/82 19 Green water well cont Lincoln
 date well completed firm name county well located

LANDOWNER: Cecil Delaughter description of formations encountered from to
Rt. 4, Box 163 Citronelle 1 60
Brookhaven, Ms.
 (mailing address)

WELL LOCATION:
 sec. 7 T 6 N R 9 E
 S W
5 miles SE of Brookhaven
 (distance) (direction) (nearest town)

WELL PURPOSE: home
 (home, irrigation, municipal, industrial)

WELL COMPLETION DATA:
 (1) diameter (inches) 4
 (2) total depth (feet) 60
 (3) static water level (feet) 45 below above
 top of ground.
 (4) casing PVC 50
 (material) (depth)
4"
 (size) if telescope see back.
 (5) screen 10' 50'
 (length) (depth to top)
.010 PVC
 (size) (material)
 (6) pump 1/2 sub 8
 (HP) (yield gpm)
electricity
 (type power)
 (7) electric log no
 (yes or no)
 (organization running log)
 (8) how well bottom plugged
back wash valve

DEPT. OF NATURAL RESOURCES
 BUREAU OF LAND & WATER RESOURCES


FEB 11 1982

RECEIVED

DRILLERS REMARKS:

If well telescopes please sketch and show depths.

GROUND LEVEL

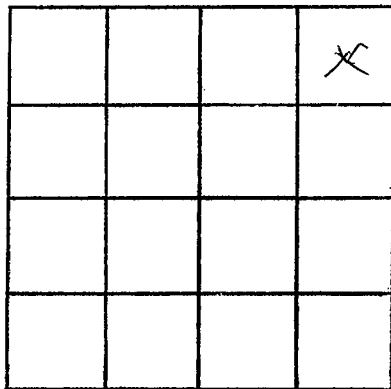

SECTION 7

Please indicate well location X.

ADDITIONAL INFORMATION

If more than one screen, show locations of each on sketch.