

MISSISSIPPI DEPARTMENT OF NATURAL RESOURCES

Bureau of Land and Water Resources

Southport Mall

P.O. Box 10631

Jackson, Mississippi 39209

WATER WELL DRILLERS LOG

<i>Lincoln</i>
<i>N</i>
<i>2036</i>

*March 30 1982* *Reems weller Lincoln*  
 date well completed firm name county well located

LANDOWNER:	description of formations encountered	from	to
<i>Bill Adams</i> <i>Mt Jayess</i> (mailing address)			
WELL LOCATION:	<i>sand</i>	<i>17</i>	<i>35</i>
sec. <i>5</i> T. <i>6</i> N. R. <i>9</i> E	<i>blue clay</i>	<i>35</i>	<i>130</i>
<i>3</i> miles <i>WNW</i> of <i>East Lincoln</i>	<i>fine sand</i>	<i>130</i>	<i>145</i>
(distance) (direction) (nearest town)	<i>clay</i>		
WELL PURPOSE: <i>home</i>	<i>coarse sand</i>	<i>145</i>	<i>160</i>
(home, irrigation, municipal, industrial)			
WELL COMPLETION DATA:			
(1) diameter (inches) <i>4"</i>			
(2) total depth (feet) <i>100</i>			
(3) static water level (feet) <i>75</i> below top of ground			
(4) casing <i>plastic bottom</i>			
(material) (depth)			
<i>5'</i> if telescope see back.			
(size)			
(5) screen <i>5'</i> <i>155'</i>			
(length) (depth to top)			
<i>4"</i> <i>plastic</i>			
(size) (material)			
(6) pump <i>1/2</i> <i>10</i>			
(HP) (yield gpm)			
<i>elect</i>			
(type power)			
(7) electric log <i>no</i>			
(yes or no)			
<i>no</i>			
(organization running log)			
(8) how well bottom plugged			
<i>back wash</i>			
DRILLERS REMARKS:			


DEPT. OF NATURAL RESOURCES  
 BUREAU OF LAND & WATER RESOURCES

AUG - 5 1982

RECEIVED

If well telescopes please sketch and show depths.

GROUND LEVEL

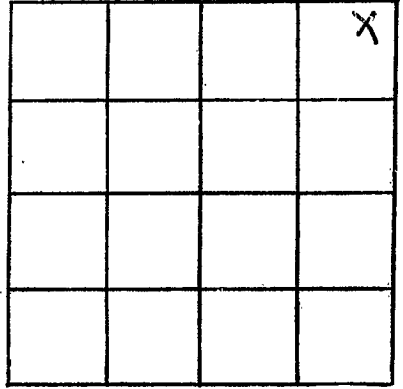

SECTION 5

Please indicate well location X.

ADDITIONAL INFORMATION

If more than one screen,  
show locations of each on sketch.