

Lincoln
N 2041
3-11-83

MISSISSIPPI DEPARTMENT OF NATURAL RESOURCES
 Bureau of Land and Water Resources
 Southport Mall
 P.O. Box 10631
 Jackson, Mississippi 39209
WATER WELL DRILLERS LOG

Mar. 11 1983 Grenn Water Well Lincoln
 date well completed firm name county well located

LANDOWNER: Roger Wilson
Rt. 4, Box 209
Brookhaven, Ms.
 (mailing address)

WELL LOCATION:
 sec. 13 T. 6 N. R. 9 E. S. 5 W.
12 miles SE of Brookhaven
 (distance) (direction) (nearest town)

WELL PURPOSE: home
 (home, irrigation, municipal, industrial)

WELL COMPLETION DATA:
 (1) diameter (inches) 4
 (2) total depth (feet) 175
 (3) static water level (feet) 70 below above top of ground.
 (4) casing PVC, 165'
 (material) (depth)
 4"
 (size) if telescope see back.
 (5) screen 10', 165'
 (length) (depth to top)
 .010, PVC
 (size) (material)
 (6) pump did not instal
 (HP) (yield gpm)

 (type power)
 (7) electric log no
 (yes or no)

 (organization running log)

description of formations encountered	from	to
	Clay	1
sand & gravel	20	58
white clay	58	100
sand	100	110
white clay	110	150
sand	150	175

(8) how well bottom plugged
back wash valve

DRILLERS REMARKS: _____


DEPT. OF NATURAL RESOURCES
 BUREAU OF LAND & WATER RESOURCES

MAY 20 1983

RECEIVED

If well telescopes please sketch and show depths.

GROUND LEVEL

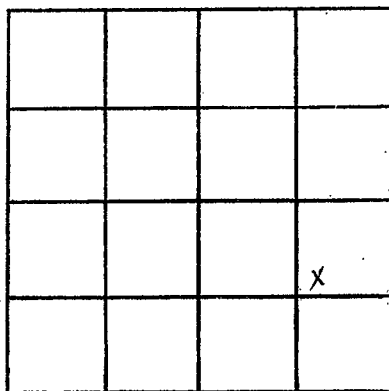

SECTION 13

Please indicate well location X.

ADDITIONAL INFORMATION

If more than one screen,
show locations of each on sketch.