

MISSISSIPPI DEPARTMENT OF NATURAL RESOURCES
Bureau of Land and Water Resources
 Southport Mall
 P.O. Box 10631
 Jackson, Mississippi 39209
WATER WELL DRILLERS LOG

Lincoln
N 2045

April 23 1984 Grenn Water Well Lincoln
 date well completed firm name county well located


LANDOWNER: Donald Grice Rt. 1, Box 154 Brookhaven, Ms. (mailing address)	description of formations encountered Citronelle	from 1	to 140
WELL LOCATION:			
sec. <u>3</u> T. <u>6</u> N. R. <u>9</u> E S W			
8 miles SE of Brookhaven (distance) (direction) (nearest town)			
WELL PURPOSE: home (home, irrigation, municipal, industrial)			
WELL COMPLETION DATA:			
(1) diameter (inches) <u>4</u>			
(2) total depth (feet) <u>140</u>			
(3) static water level (feet) <u>75</u> below above top of ground.			
(4) casing <u>PVC</u> , <u>130'</u> (material) (depth) <u>4"</u> if telescope see back. (size)			
(5) screen <u>10'</u> , <u>130'</u> (length) (depth to top) <u>.010</u> , <u>PVC</u> (size) (material)			
(6) pump <u>1/2 sub 8</u> (HP) (yield gpm) <u>electricity</u> (type power)			
(7) electric log <u>no</u> (yes or no) (organization running log)			
(8) how well bottom plugged <u>backwash valve</u>			
DRILLERS REMARKS:			

DEPT. OF NATURAL RESOURCES
 BUREAU OF LAND & WATER RESOURCES

JUN 11 1984
RECEIVED

If well telescopes please sketch and show depths.

GROUND LEVEL

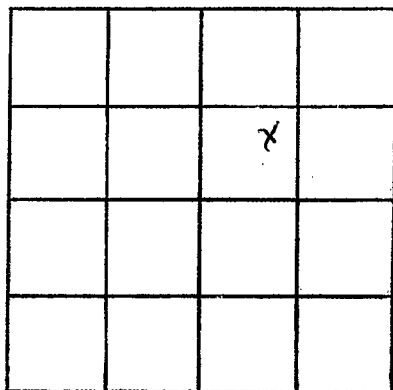

SECTION 3

Please indicate well location X.

ADDITIONAL INFORMATION

If more than one screen,
show locations of each on sketch.