

MISSISSIPPI DEPARTMENT OF NATURAL RESOURCES

Bureau of Land and Water Resources

Southport Mall

P.O. Box 10631

Jackson, Mississippi 39209

WATER WELL DRILLERS LOG

Lewis
N 2048

June 25 19 84 Gremm Water Well Lincoln
date well completed firm name county well located

LANDOWNER: <u>Ellzey Lewis</u>	description of formations encountered	from	to
Rt. 1			
<u>Bogue Chitto, Ms.</u> (mailing address)			
WELL LOCATION: sec. <u>30</u> T <u>6</u> N R <u>9</u> E S W <u>6</u> miles E of <u>Bogue Chitto</u> (distance) (direction) (nearest town)			
WELL PURPOSE: <u>home</u> (home, irrigation, municipal, industrial)			
WELL COMPLETION DATA:			
(1) diameter (inches) <u>4</u>			
(2) total depth (feet) <u>89</u>			
(3) static water level (feet) <u>56</u> below top of ground.			
(4) casing <u>PVC</u> , <u>79'</u> (material) (depth) <u>4"</u> if telescope see back. (size)			
(5) screen <u>10'</u> , <u>79'</u> (length) (depth to top) <u>.010</u> PVC (size) (material)			
(6) pump <u>1/2</u> sub <u>8</u> (HP) (yield gpm) <u>electricity</u> (type power)			
(7) electric log <u>no</u> (yes or no) <u>(organization running log)</u>			
(8) how well bottom plugged <u>back wash valve</u>			
DRILLERS REMARKS:			


DEPT. OF NATURAL RESOURCES
BUREAU OF LAND & WATER RESOURCES

SEP 18 1984

RECEIVED

If well telescopes please sketch and show depths.

GROUND LEVEL

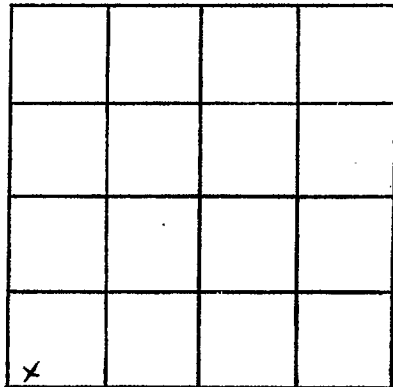

SECTION 30

Please indicate well location X.

ADDITIONAL INFORMATION

If more than one screen, show locations of each on sketch.