

MISSISSIPPI DEPARTMENT OF NATURAL RESOURCES

Bureau of Land and Water Resources

Southport Mall

P.O. Box 10631

Jackson, Mississippi 39209

WATER WELL DRILLERS LOG

<u>LINCOLN</u>
<u>N 2049</u>

7-3 1985 Green Water Well LIncoln
 date well completed firm name county well located

LANDOWNER: Danny Segura
111 Mary Beth Ave.
Houma, La.
 (mailing address)


description of formations encountered	from	to
clay	1	20
sand & gravel	20	35
white clay	35	55
blue clay	55	96
white clay	95	120
sand	120	173

WELL LOCATION:
 sec. 1 T. 6 N. R. 9 E
 S W
11 miles east of Brookhaven
 (distance) (direction) (nearest town)

WELL PURPOSE: home
 (home, irrigation, municipal, industrial)

- WELL COMPLETION DATA:**
- (1) diameter (inches) 4
 - (2) total depth (feet) 173
 - (3) static water level (feet) 66 below above top of ground.
 - (4) casing PVC 163
 (material) (depth)
4"
 (size) if telescope see back.
 - (5) screen 10' 163'
 (length) (depth to top)
.010 PVC
 (size) (material)
 - (6) pump did not install
 (HP) (yield gpm)
 (type power)
 - (7) electric log no
 (yes or no)
 (organization running log)
 - (8) how well bottom plugged back wash valve


DRILLERS REMARKS:

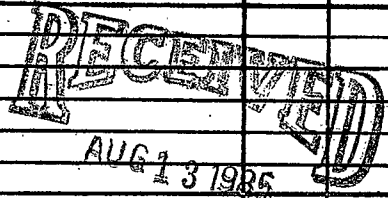

Department of Natural Resources
 Bureau of Land & Water Resources

If well telescopes please sketch and show depths.

GROUND LEVEL

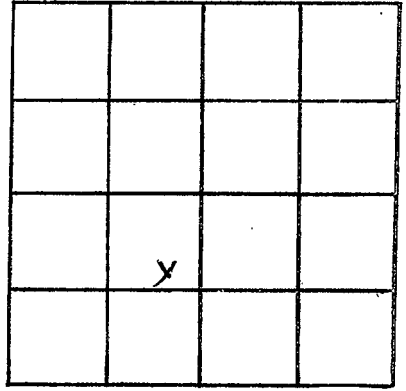

SECTION 1

Please indicate well location X.

ADDITIONAL INFORMATION

If more than one screen,
show locations of each on sketch.