

MISSISSIPPI DEPARTMENT OF NATURAL RESOURCES
Bureau of Land and Water Resources
 Southport Mall
 P.O. Box 10631
 Jackson, Mississippi 39209
WATER WELL DRILLERS LOG

Lincoln
N 2050

Oct. 4 1985 Grenn Water Well Lincoln
 date well completed firm name county well located

LANDOWNER: Jess Beeson
 Rt. 4
 Brookhaven, Ms.
 (mailing address)

description of formations encountered	from	to
	Citronelle	1

WELL LOCATION:
 sec. 15 T 6 N R 9 E
 S W
 9 miles SE Brookhaven
 (distance) (direction) (nearest town)

WELL PURPOSE: home
 (home, irrigation, municipal, industrial)

WELL COMPLETION DATA:

(1) diameter (inches) 4

(2) total depth (feet) 100

(3) static water level (feet) 73 below above top of ground.

(4) casing PVC 80
 (material) (depth)
 4" if telescope see back.
 (size)


(5) screen 20' 80'
 (length) (depth to top)
 .010 PVC
 (size) (material)

(6) pump 1 hp sub 18
 (HP) (yield gpm)
 electricity
 (type power)

(7) electric log no
 (yes or no)
 (organization running log)

(8) how well bottom plugged back wash valve

DRILLERS REMARKS:

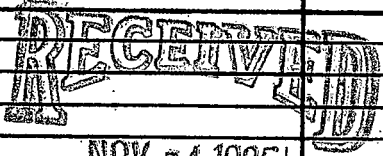


NOV - 1 1985

Department of Natural Resources
 Bureau of Land & Water Resources

If well telescopes please sketch and show depths.

GROUND LEVEL

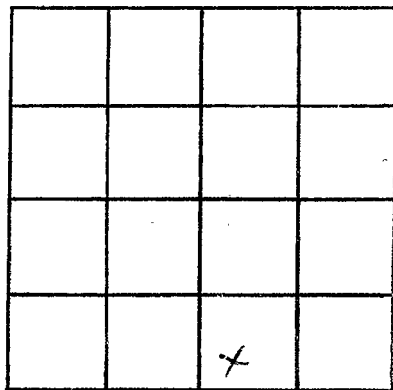

SECTION 15

Please indicate well location X.

ADDITIONAL INFORMATION

If more than one screen,
show locations of each on sketch.