

MISSISSIPPI DEPARTMENT OF NATURAL RESOURCES

Bureau of Land and Water Resources

Southport Mall

P.O. Box 10631

Jackson, Mississippi 39209

WATER WELL DRILLERS LOG

LINCOLN
N 2057
Sept. 19

1985 Grenn Water Well Lincoln
date well completed firm name county well located

LANDOWNER: Robert Evans
Rt. 1, Box 251
Monticello, Ms.
(mailing address)

description of formations encountered
Citronelle
from 1 to 107


WELL LOCATION:
sec. 31 T 6 N R 9 E
S W
7 miles East Bogue Chitto
(distance) (direction) (nearest town)

WELL PURPOSE: home
(home, irrigation, municipal, industrial)

WELL COMPLETION DATA:
(1) diameter (inches) 4
(2) total depth (feet) 107
(3) static water level (feet) 50 below above top of ground.
(4) casing PVC 97
(material) (depth)
4" if telescope see back.
(size)
(5) screen 10' 97'
(length) (depth to top)
.010 PVC
(size) (material)
(6) pump 1/2 sub 8
(HP) (yield gpm)
electricity
(type power)
(7) electric log no
(yes or no)
(organization running log)

(8) how well bottom plugged
back wash valve

DRILLERS REMARKS:

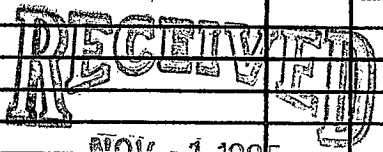

NOV - 1 1985

Department of Natural Resources
Bureau of Land & Water Resources

If well telescopes please sketch and show depths.

GROUND LEVEL

			X

SECTION 31

Please indicate well location X.

ADDITIONAL INFORMATION

If more than one screen,
show locations of each on sketch.