

MISSISSIPPI DEPARTMENT OF NATURAL RESOURCES
Bureau of Land and Water Resources
 Southport Mall
 P.O. Box 10631
 Jackson, Mississippi 39209
WATER WELL DRILLERS LOG

LINCOLN
N 2652

7-1-86 19 Grenn Water Well Lincoln
 date well completed firm name county well located

LANDOWNER: Jim Galey
 Rt. 1, Box 89
 Ruth, Ms.
 (mailing address)

description of formations encountered	from	to
Citronelle	1	110

WELL LOCATION:
 sec. 24 T. 6 N. R. 9 E
 S W
 13 miles SE of Brookhaven
 (distance) (direction) (nearest town)

WELL PURPOSE: home
 (home, irrigation, municipal, industrial)

- WELL COMPLETION DATA:**
- diameter (inches) 4
 - total depth (feet) 110
 - static water level (feet) 58 below above top of ground.
 - casing PVC, 100 (material), (depth)
 4" if telescope see back. (size)
 - screen 10' (length), 100' (depth to top)
 .010, PVC (size) (material)
 - pump 1/2 sub 10 (HP) (yield gpm)
 electricity (type power)
 - electric log no (yes or no)
 (organization running log)
 - how well bottom plugged back wash valve


RECEIVED
 JUL 27 1986

Department of Natural Resources
 Bureau of Land & Water Resources

DRILLERS REMARKS:

If well telescopes please sketch and show depths.

GROUND LEVEL

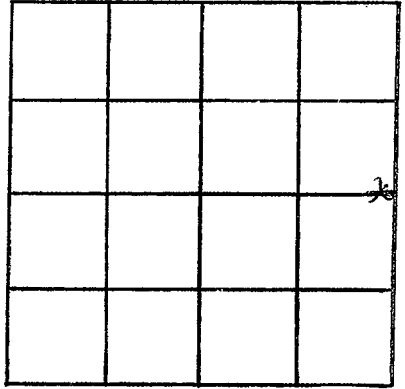

SECTION 24

Please indicate well location X.

ADDITIONAL INFORMATION

If more than one screen,
show locations of each on sketch.