

MISSISSIPPI DEPARTMENT OF NATURAL RESOURCES

Bureau of Land and Water Resources

P.O. Box 10631

Jackson, Mississippi 39209

WATER WELL DRILLERS LOG

COUNTY WELL LOCATED <i>Lincoln</i>	
WELL NUMBER N 2053	CODED
DATE WELL COMPLETED 1-2-87	

PERMIT NUMBER
NAME OF DRILLING FIRM <i>Gunnwater Well & Supply, Inc.</i>

NAME & MAILING ADDRESS OF LANDOWNER <i>C. M. Smith</i>		
<i>Route 4 Box 250 A</i>		
<i>Brookhaven, Miss</i>		
WELL LOCATION: SEC <u>7</u>	TOWNSHIP <u>6</u> ^(N) _(S)	RANGE <u>9</u> ^(E) _(W)
DISTANCE <u>6</u> Miles	DIRECTION <u>S-E.</u>	NEAREST TOWN <u>Brookhaven</u>
OTHER LANDMARK		
WELL PURPOSE: Home, Irrigation, Municipal, Industrial, Fish Pond, etc. <i>home</i>		

PUMP DATA		
PUMP TYPE (Circle One): <input checked="" type="radio"/> Submersible <input type="radio"/> Turbine <input type="radio"/> Jet <input type="radio"/> Flowing Well, Other (Describe) _____		
POWER TYPE (Circle One): <input checked="" type="radio"/> Electric <input type="radio"/> Tractor <input type="radio"/> Diesel <input type="radio"/> Gasoline <input type="radio"/> Butane, Other (Describe) _____		
Pump Capacity (GPM) <i>10</i>	No. of Stages <i>10</i>	Setting Depth <i>63</i> FT.
PUMP TEST		
Well yielded <i>14</i> GPM with a drawdown of <i>None</i> ft. after <i>10 min</i> hours of pumping		


WELL DATA		
Well Depth <i>70</i>	Casing Diameter (In.) <i>4</i>	Casing Length (Ft.) <i>60</i>
Type of Casing <i>PVC</i>	Hole Depth <i>75</i>	Depth to Static Water Level <i>40</i>
TYPE OF COMPLETION: (Circle One or More): <input checked="" type="radio"/> Gravel Packed <input type="radio"/> Underreamed <input type="radio"/> Telescoped, <input type="radio"/> Natural Development <input type="radio"/> Open Hole <input type="radio"/> Other		
Top of Lap Pipe or Reduction in Casing		
FEET		IF TELESCOPED OR MORE THAN ONE SCREEN: USE BACK PAGE

LOG DATA		
TYPE OF LOG RUN (Circle One): <input type="radio"/> Electric <input type="radio"/> Gamma Ray <input type="radio"/> Density <input type="radio"/> Sonic <input checked="" type="radio"/> No Log Run, <input type="radio"/> Other (Describe) _____		
Name of Organization Running Log		

SCREEN DATA		
Diameter - Inches <i>4</i>	Length - Feet <i>10</i>	Slot Size - Inches <i>.010</i>
Screen Type <i>PVC</i>		Depth to Bottom - Feet <i>70</i>

GEOLOGIC DATA (Office Use Only)			
Surface Elev.	Geologic Unit	Unit Thickness	Depth to Top
Subs. SWL	Date	Analysis	Aquifer Test

Driller's Remarks

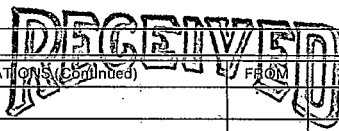

APR 10 1987

Department of Natural Resources
Bureau of Land & Water Resources

DESCRIPTION OF FORMATIONS ENCOUNTERED	FROM	TO	FORMATIONS (Continued) FROM TO
<i>Citronelle</i>	<i>1</i>	<i>75</i>	
IF MORE SPACE IS NEEDED, USE BACK			

If well telescopes please sketch and show depths.

GROUND LEVEL

		X	

SECTION 7

Please indicate well location X.

ADDITIONAL INFORMATION

If more than one screen, show location of each on sketch.