

MISSISSIPPI DEPARTMENT OF NATURAL RESOURCES

Bureau of Land and Water Resources

P.O. Box 10

Jackson, Mississippi 39204

WATER WELL DRILLERS LOG

COUNTY WELL LOCATED  
Leflore

WELL NUMBER  
N 2064

CODED

DATE WELL COMPLETED  
11-7-89

PERMIT NUMBER

NAME OF DRILLING FIRM  
Green Water Well Supply, Inc.

NAME & MAILING ADDRESS OF LANDOWNER  
Buford Gill

Rt 1 Box 418

Brookhaven, Ms.

WELL LOCATION: SEC 6 TOWNSHIP 6 RANGE 9 N E  
S W

DISTANCE 7 Miles DIRECTION SE of NEAREST TOWN Brookhaven

OTHER LANDMARK

WELL PURPOSE: Home Irrigation, Municipal, Industrial, Fish Pond, etc.

PUMP DATA

PUMP TYPE (Circle One):  
Submersible, Turbine, Jet, Flowing Well,  
Other (Describe) did not install

POWER TYPE (Circle One):  
Electric, Tractor, Diesel, Gasoline, Butane,  
Other (Describe) \_\_\_\_\_ H/P \_\_\_\_\_

Pump Capacity (GPM) \_\_\_\_\_ No. of Stages \_\_\_\_\_ Setting Depth \_\_\_\_\_ FT.

PUMP TEST

Well yielded \_\_\_\_\_ GPM with  
a drawdown of \_\_\_\_\_ ft.  
after \_\_\_\_\_ hours of pumping

WELL DATA

Well Depth <u>190</u>	Casing Diameter (In.) <u>4</u>	Casing Length (Ft.) <u>180</u>
Type of Casing <u>PVC</u>	Hole Depth <u>200</u>	Depth to Static Water Level <del>180</del> <u>98</u>

TYPE OF COMPLETION: (Circle One or More):  
Gravel Packed Underreamed, Telescoped,  
Natural Development, Open Hole, Other

Top of Lap Pipe or Reduction in Casing  
FEET \_\_\_\_\_ IF TELESCOPED OR MORE THAN ONE SCREEN: USE BACK PAGE

LOG DATA

TYPE OF LOG RUN (Circle One): No Log Run  
Electric, Gamma Ray, Density, Sonic, Neutron,  
Other (Describe) \_\_\_\_\_

Name of Organization Running Log

SCREEN DATA

Diameter - Inches <u>4</u>	Length - Feet <u>10</u>	Slot Size - Inches <u>.010</u>
Screen Type <u>PVC</u>	Depth to Bottom - Feet <u>190</u>	

GEOLOGIC DATA (Office Use Only)

Surface Elev.	Geologic Unit	Unit Thickness	Depth to Top
Subs. SWL	Date	Analysis	Aquifer Test

Driller's Remarks

DESCRIPTION OF FORMATIONS ENCOUNTERED	FROM	TO
<u>Sandy Clay</u>	<u>20</u>	<u>45</u>
<u>Clay</u>	<u>45</u>	<u>160</u>
<u>Sand</u>	<u>160</u>	<u>200</u>

FORMATIONS (Continued)

FROM TO

**RECEIVED**

**FEB 13 1990**

Department of Natural Resources  
Bureau of Land & Water Resources


IF MORE SPACE IS NEEDED, USE BACK

**RESOURCES**

0631

well telescopes please sketch and show depths.

GROUND LEVEL

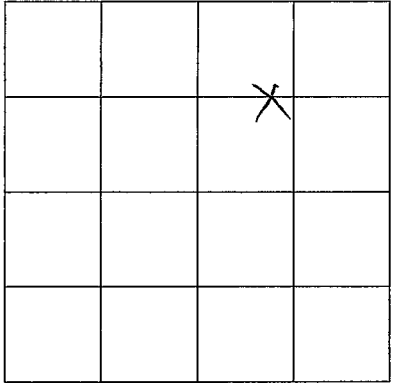

SECTION 6

Please indicate well location X.

ADDITIONAL INFORMATION

If more than one screen, show location of each on sketch.