

MISSISSIPPI DEPARTMENT OF NATURAL RESOURCES

Bureau of Land and Water Resources

P.O. Box 10631

Jackson, Mississippi 39209

WATER WELL DRILLERS LOG

COUNTY WELL LOCATED <i>Lincoln</i>	
WELL NUMBER <i>N 2067</i>	CODED
DATE WELL COMPLETED <i>4/25/88</i>	

PERMIT NUMBER
NAME OF DRILLING FIRM <i>Easley's Water Well</i>
<i>Brookhaven, MS. 39601</i>

NAME & MAILING ADDRESS OF LANDOWNER <i>Lavon Boyte</i>			
<i>Brookhaven, MS.</i>			
<i>39601</i>			
WELL LOCATION:	SEC	TOWNSHIP	RANGE
<i>Lincoln</i>	<i>1</i>	<i>6</i>	<i>N 9 E</i>
DISTANCE	DIRECTION	NEAREST TOWN	
<i>15</i> Miles	<i>E</i>	of <i>Brookhaven</i>	
OTHER LANDMARK <i>4 miles from East Lincoln Fire Dept.</i>			
WELL PURPOSE: Home, Irrigation, Municipal, Industrial, Fish Pond, etc. <i>Home</i>			

PUMP DATA		
PUMP TYPE (Circle One): Submersible, Turbine, Jet, Flowing Well, Other (Describe) <i>NO PUMP</i>		
POWER TYPE (Circle One): Electric, Tractor, Diesel, Gasoline, Butane, Other (Describe) _____ H/P _____		
Pump Capacity (GPM)	No. of Stages	Setting Depth FT.
PUMP TEST		
Well yielded _____ GPM with a drawdown of _____ ft. after _____ hours of pumping		

WELL DATA		
Well Depth <i>115 ft.</i>	Casing Diameter (In.) <i>4 in.</i>	Casing Length (Ft.) <i>95 ft.</i>
Type of Casing <i>PVC #40</i>	Hole Depth <i>115 ft.</i>	Depth to Static Water Level
TYPE OF COMPLETION: (Circle One or More): <i>Natural Development</i> , Underreamed, Telescoped, Open Hole, Other		
Top of Lap Pipe or Reduction in Casing FEET <input type="checkbox"/> IF TELESCOPED OR MORE THAN ONE SCREEN: USE BACK PAGE		

LOG DATA	
TYPE OF LOG RUN (Circle One): Electric, Gamma Ray, Density, Sonic, Neutron, Other (Describe) _____ No Log Run	
Name of Organization Running Log	

SCREEN DATA		
Diameter - Inches <i>4 in.</i>	Length - Feet <i>20 ft.</i>	Slot Size - Inches <i>0.10</i>
Screen Type <i>PVC</i>	Depth to Bottom - Feet <i>115 ft.</i>	


GEOLOGIC DATA (Office Use Only)			
Surface Elev.	Geologic Unit	Unit Thickness	Depth to Top
Subs. SWL	Date	Analysis	Aquifer Test
Driller's Remarks			

DESCRIPTION OF FORMATIONS ENCOUNTERED	FROM	TO	FORMATION(S) CONTAINED	FROM	TO
<i>clay</i>	<i>0</i>	<i>20 ft.</i>	<div style="border: 2px solid black; padding: 5px; display: inline-block;"> RECEIVED APR 16 1990 </div> Department of Natural Resources Bureau of Land & Water Resources		
<i>gravel</i>	<i>20 ft.</i>	<i>50 ft.</i>			
<i>fine sand</i>	<i>50 ft.</i>	<i>90 ft.</i>			
<i>coarse sand</i>	<i>90 ft.</i>	<i>115 ft.</i>			

IF MORE SPACE IS NEEDED, USE BACK

If well telescopes please
sketch and show depths.

GROUND LEVEL

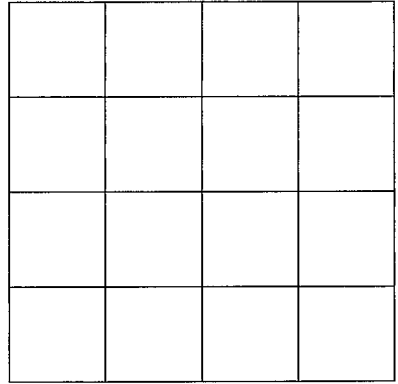

SECTION _____

Please indicate well location X.

ADDITIONAL INFORMATION

If more than one screen,
show location of each on sketch.