

**MISSISSIPPI DEPARTMENT OF ENVIRONMENTAL QUALITY**  
Bureau of Land and Water Resources

P. O. Box 10631  
Jackson, MS 39289-0631  
**WATER WELL DRILLERS LOG**

COUNTY WELL LOCATED <i>Lincoln</i>	
WELL NUMBER <i>N 2075</i>	CODED
DATE WELL COMPLETED <i>7/16-93</i>	

PERMIT NUMBER
NAME OF DRILLING FIRM <i>Green Water Well &amp; Supply</i>

*#2*

NAME & MAILING ADDRESS OF LANDOWNER <i>Buddy Riels</i>		
<i>Rt 4 Box 19A</i>		
<i>Brookhaven MS</i>		
WELL LOCATION: SEC	TOWNSHIP	RANGE
<i>3</i>	<i>6 S</i>	<i>9 E</i>
DISTANCE	DIRECTION	NEAREST TOWN
<i>9</i> Miles	<i>SE</i>	of <i>Brookhaven</i>
OTHER LANDMARK		
WELL PURPOSE: Home, Irrigation, Municipal, Industrial, Fish Pond, etc. <i>Chicken Houney</i>		

PUMP DATA		
PUMP TYPE (Circle One): <input checked="" type="checkbox"/> Submersible    Turbine,    Jet    Flowing Well, Other (Describe) _____		
POWER TYPE (Circle One): <input checked="" type="checkbox"/> Electric    Tractor,    Diesel,    Gasoline,    Butane, Other (Describe) _____ H/P <i>1 1/2</i>		
Pump Capacity (GPM)	No. of Stages	Setting Depth
		<i>100</i> FT.
PUMP TEST		
Well yielded	<i>16</i>	GPM with
a drawdown of	<i>0</i>	ft.
after	_____	hours of pumping

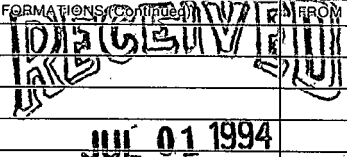
WELL DATA		
Well Depth <i>186</i>	Casing Diameter (In.) <i>4 in.</i>	Casing Length (Ft.) <i>175</i>
Type of Casing <i>PVC</i>	Hole Depth <i>195</i>	Depth to Static Water Level <i>73</i>
TYPE OF COMPLETION: (Circle One or More): <input checked="" type="checkbox"/> Gravel Packed    Underreamed,    Telescoped, Natural Development,    Open Hole,    Other		
Top of Lap Pipe or Reduction in Casing		
FEET	IF TELESCOPED OR MORE THAN ONE SCREEN: USE BACK PAGE	

LOG DATA	
TYPE OF LOG RUN (Circle One): Electric, Gamma Ray, Density, Sonic, <input checked="" type="checkbox"/> No Log Run, Neutron, Other (Describe) _____	
Name of Organization Running Log	

SCREEN DATA		
Diameter - Inches <i>4 in.</i>	Length - Feet <i>10 ft.</i>	Slot Size - Inches <i>.010</i>
Screen Type <i>PVC</i>	Depth to Bottom - Feet <i>185</i>	

GEOLOGIC DATA (Office Use Only)			
Surface Elev.	Geologic Unit	Unit Thickness	Depth to Top
Subs. SWL	Date	Analysis	Aquifer Test
Driller's Remarks			

DESCRIPTION OF FORMATIONS ENCOUNTERED	FROM	TO
<i>Sand &amp; Gravel Mix</i>	<i>0</i>	<i>30</i>
<i>Clay</i>	<i>30</i>	<i>138</i>
<i>Sand &amp; Gravel Mix</i>	<i>138</i>	<i>195</i>

FORMATIONS (Continued)	FROM	TO
		
<b>JUL 01 1994</b>		
Dept. of Environmental Quality Office of Land & Water Resources		
IF MORE SPACE IS NEEDED, USE BACK		

If well telescopes please sketch and show depths.

GROUND LEVEL

	X		

SECTION 3

Please indicate well location X.

ADDITIONAL INFORMATION

If more than one screen,  
show location of each on sketch.