

MISSISSIPPI DEPARTMENT OF ENVIRONMENTAL QUALITY

Office of Land and Water Resources

P. O. Box 10631
Jackson, MS 39289-0631

WATER WELL DRILLERS LOG

COUNTY WELL LOCATED <i>Lincoln</i>	
WELL NUMBER N 2080	CODED
DATE WELL COMPLETED 11-1-95	

PERMIT NUMBER
NAME OF DRILLING FIRM <i>Green Water Well & Supply</i>

NAME & MAILING ADDRESS OF LANDOWNER <i>Lewis Mager III</i>			
<i>1510 Lambert Ln SE</i>			
<i>Brookhaven MS 39601</i>			
WELL LOCATION:	SEC	TOWNSHIP	RANGE
	<u>18</u>	<u>6</u>	<u>9</u>
		<u>S</u>	<u>W</u>
DISTANCE	DIRECTION	NEAREST TOWN	
<u>6 1/2</u> Miles	<u>SE</u>	of <u>Brookhaven</u>	
OTHER LANDMARK			
WELL PURPOSE: <input checked="" type="checkbox"/> Home Irrigation, <input type="checkbox"/> Municipal, <input type="checkbox"/> Industrial, <input type="checkbox"/> Fish Pond, etc.			

PUMP DATA		
PUMP TYPE (Circle One): Submersible, Turbine, Jet, Flowing Well, Other (Describe) _____		
POWER TYPE (Circle One): Electric, Tractor, Diesel, Gasoline, Butane, Other (Describe) _____		
Pump Capacity (GPM)	No. of Stages	Setting Depth
		_____ FT.
PUMP TEST		
Well yielded _____ GPM with		
a drawdown of _____ ft.		
after _____ hours of pumping		

WELL DATA		
Well Depth <u>99</u>	Casing Diameter (In.) <u>4</u>	Casing Length (Ft.) <u>89</u>
Type of Casing <u>PVC</u>	Hole Depth <u>110</u>	Depth to Static Water Level <u>43</u>
TYPE OF COMPLETION: (Circle One or More): <input checked="" type="checkbox"/> Gravel Packed, <input type="checkbox"/> Underreamed, <input type="checkbox"/> Telescoped, <input type="checkbox"/> Natural Development, <input type="checkbox"/> Open Hole, <input type="checkbox"/> Other (Describe) _____		
WELL GROUTED TO A DEPTH OF <u>10</u> FEET Type Grout (circle one): Cement, Bentonite, or <u>Mix</u>		


LOG DATA	
TYPE OF LOG RUN (Circle One): Electric, Gamma Ray, Density, Sonic, Neutron, Other (Describe) _____	
Name of Organization Running Log	

SCREEN DATA		
Diameter - Inches <u>4</u>	Length - Feet <u>10</u>	Slot Size - Inches <u>.010</u>
Screen Type <u>PVC</u>	Depth to Bottom - Feet <u>99</u>	

GEOLOGIC DATA (Office Use Only)			
Surface Elev.	Geologic Unit	Unit Thickness	Depth to Top
Subs. SWL	Date	Analysis	Aquifer Test

Driller's Remarks
Top of Lap Pipe or Reduction in Casing
IF TELESKOPED OR MORE THAN ONE SCREEN, USE BACK PAGE FEET FROM FORMATIONS (Continued) FROM TO


DESCRIPTION OF FORMATIONS ENCOUNTERED	FROM	TO
<i>Red Clay</i>	<u>0</u>	<u>19</u>
<i>Gravel & Sand</i>	<u>19</u>	<u>99</u>
<i>White Clay</i>	<u>99</u>	<u>109</u>

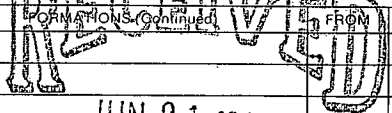
JUN 21 1996
 Dept. of Environmental Quality
 Office of Land & Water Resources

IF MORE SPACE IS NEEDED, USE BACK

If well telescopes please sketch and show depths.

GROUND LEVEL

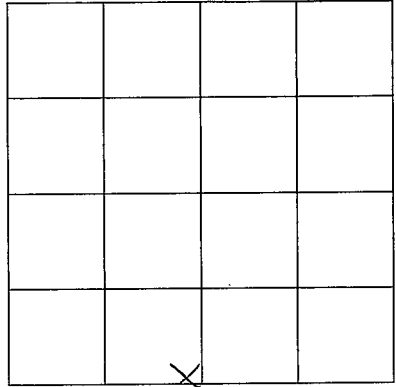

SECTION 18

Please indicate well location X.

ADDITIONAL INFORMATION

If more than one screen,
show location of each on sketch.