

MISSISSIPPI DEPARTMENT OF ENVIRONMENTAL QUALITY

Office of Land and Water Resources

P. O. Box 10631
Jackson, MS 39289-0631
WATER WELL DRILLERS LOG

COUNTY WELL LOCATED
Lincoln

WELL NUMBER CODED
N 2083

DATE WELL COMPLETED
5-11-98

PERMIT NUMBER
119

NAME OF DRILLING CONTRACTOR
Water Well & Supply
119 Prichard Dr. SE
Juno Chitto, MS 39629

NAME & MAILING ADDRESS OF LANDOWNER
Jo Cloy
Rt. 2, Box 116 B
Rosie

WELL LOCATION: SEC 3 TOWNSHIP 6 S RANGE 9 W

DISTANCE DIRECTION NEAREST TOWN
8 Miles SE of Brookhaven

OTHER LANDMARK

WELL PURPOSE: Irrigation, Municipal, Industrial, Fish Pond, etc.

PUMP DATA

PUMP TYPE (Circle One):
 Submersible, Turbine, Jet Flowing Well,
Other (Describe) _____

POWER TYPE (Circle One):
 Electric, Tractor, Diesel, Gasoline, Butane,
Other (Describe) _____ H/P 3/4

Pump Capacity (GPM) No. of Stages Setting Depth
10 12 155 FT.

PUMP TEST

Well yielded 9 GPM with
a drawdown of 0 ft.
after 1 hours of pumping

WELL DATA

Well Depth <u>190'</u>	Casing Diameter (In.) <u>4"</u>	Casing Length (Ft.) <u>180'</u>
Type of Casing <u>PVC</u>	Hole Depth <u>209'</u>	Depth to Static Water Level <u>125'</u>

TYPE OF COMPLETION: (Circle One or More):
 Gravel Packed, Underreamed, Telescoped,
 Natural Development, Open Hole, Other

WELL GROUTED TO A DEPTH OF 10 FEET
Type Grout (circle one): Cement, Bentonite, or Mix

LOG DATA

TYPE OF LOG RUN (Circle One):
 No Log Run, Electric, Gamma Ray, Density, Sonic, Neutron,
Other (Describe) _____

Name of Organization Running Log

SCREEN DATA

Diameter - Inches <u>4"</u>	Length - Feet <u>10'</u>	Slot Size - Inches <u>.010</u>
Screen Type <u>PVC</u>	Depth to Bottom - Feet <u>190'</u>	


GEOLOGIC DATA (Office Use Only)

Surface Elev.	Geologic Unit	Unit Thickness	Depth to Top
Subs. SWL	Date	Analysis	Aquifer Test

Driller's Remarks

Top of Lap Pipe or Reduction in Casing

FEET IF TELESCOPED OR MORE THAN ONE SCREEN: USE BACK PAGE

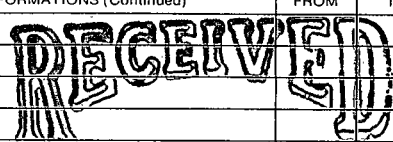DESCRIPTION OF FORMATIONS ENCOUNTERED	FROM	TO	FORMATIONS (Continued)	FROM	TO
Red Sandy Clay	0	50	 JAN 25 1999 Dept. of Environmental Quality Office of Land & Water Resources		
Gravel	50	67			
White Clay	67	120			
Blue Clay	120	160			
Sand/Gravel	160	209			

IF MORE SPACE IS NEEDED, USE BACK

If well telescopes please sketch and show depths.


GROUND LEVEL

	x		

SECTION 3

Please indicate well location X.

ADDITIONAL INFORMATION

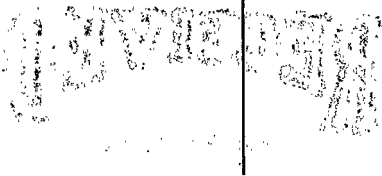

44-100-100-100
 44-100-100-100

If more than one screen, show location of each on sketch.