

MISSISSIPPI DEPARTMENT OF ENVIRONMENTAL QUALITY
Office of Land and Water Resources

COUNTY WELL LOCATED
Lincoln

WELL NUMBER _____ CODED _____

N 2091

DATE WELL COMPLETED
4/6/01

PERMIT NUMBER
Crenn Water Well & Supply

NAME OF SPECIAL CONTRACTOR
Boyle Chitto, MS 39029

P. O. Box 10631
Jackson, MS 39289-0631
WATER WELL DRILLERS LOG

NAME & MAILING ADDRESS OF LANDOWNER
Jamie Crane
3220 Union Rd
Brookhaven

WELL LOCATION: SEC _____ TOWNSHIP _____ RANGE _____
4 6 N 9 W

DISTANCE _____ MILES _____ DIRECTION _____ of _____ NEAREST TOWN _____
8 Miles SE of Brookhaven

OTHER LANDMARK _____

WELL PURPOSE: Home, Irrigation, Municipal, Industrial, Fish Pond, etc.

PUMP DATA

PUMP TYPE (Circle One):
Submersible, Turbine, Jet, Flowing Well,
Other (Describe) _____

POWER TYPE (Circle One):
Electric, Tractor, Diesel, Gasoline, Butane,
Other (Describe) _____ H/P _____

Pump Capacity (GPM) _____ No. of Stages _____ Setting Depth _____ FT.

PUMP TEST
Well yielded _____ GPM with
a drawdown of _____ ft.
after _____ hours of pumping

WELL DATA

Well Depth <u>197'</u>	Casing Diameter (In.) <u>4"</u>	Casing Length (Ft.) <u>187'</u>
Type of Casing <u>PVC</u>	Hole Depth <u>204'</u>	Depth to Static Water Level <u>93</u>

TYPE OF COMPLETION: (Circle One or More):
 Gravel Packed, Underreamed, Telescoped,
 Natural Development, Open Hole, Other

LOG DATA

TYPE OF LOG RUN (Circle One): No Log Run
Electric, Gamma Ray, Density, Sonic, Neutron,
Other (Describe) _____

Name of Organization Running Log _____

WELL GROUTED TO A DEPTH OF 10 FEET
Type Grout (circle one): Cement, Bentonite, or Mix

GEOLOGIC DATA (Office Use Only)

Surface Elev.	Geologic Unit	Unit Thickness	Depth to Top
Subs. SWL	Date	Analysis	Aquifer Test

SCREEN DATA

Diameter - Inches <u>4"</u>	Length - Feet <u>10'</u>	Slot Size - Inches <u>.010</u>
Screen Type <u>PVC</u>	Depth to Bottom, - Feet <u>187'</u>	

Driller's Remarks _____

Top of Lap Pipe or Reduction in Casing _____

FEET IF TELESCOPED OR MORE THAN ONE SCREEN: USE BACK PAGE


DESCRIPTION OF FORMATIONS ENCOUNTERED	FROM	TO
<u>Red Clay</u>	<u>0</u>	<u>12</u>
<u>Sand or Gravel</u>	<u>12</u>	<u>50</u>
<u>White Clay</u>	<u>50</u>	<u>57</u>
<u>Blue Clay</u>	<u>57</u>	<u>145</u>
<u>White Clay</u>	<u>145</u>	<u>185</u>
<u>Sand</u>	<u>185</u>	<u>204</u>

FORMATIONS (Continued)	FROM	TO

REC'D JUN 13 2001

If well telescopes please
sketch and show depths.

GROUND LEVEL

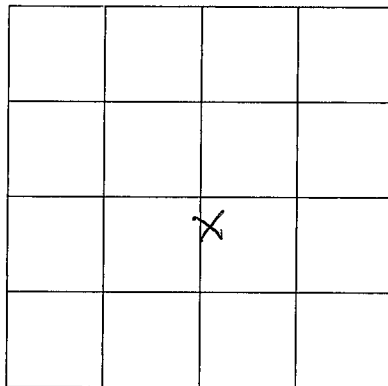

SECTION 4

Please indicate well location X.

ADDITIONAL INFORMATION

If more than one screen,
show location of each on sketch.