

AMITE

MISSISSIPPI BOARD OF WATER COMMISSIONERS

LINCOLN

02
9-16-60

CODED WATER WELL DRILLERS LOG

300

Date: 9-16, 1960, Driller: Chester Repurs County Lincoln

(Name)

(1) Owner of Land: Sam Perkins (Name)

RFD 2, Summit Miss (Address)

(2) Location: 1/4, 1/4, Sec. 35 T. 2 R. 5
8 miles west of Summit (distance) (direction) (Nearest Town)

(3) Topography: Hilly = level (Hilly) (Flat) (Level)

(4) Purpose of Well: Domestic (Domestic Irrigation Municipal, Industrial, Other)

Description & Color of Materials Sand, Clay, Red Clay, Shell, etc.	Thick- ness Feet	Depth Feet
Red clay	25	25
Red sandy	15	40
Red chalk	15	55
wh. to chalk & sand	15	70
Red sandy soil	25	95
small pebbles & sand	8	143

Information upon completion of well:

(1) Diameter 2 inches.

(2) Total Depth 143 feet.

(3) Water Level 85 feet below top of ground.

(4) Cased to Bottom Size 2"


(5) Screen: Size 1/4, Length 6"

(6) Were any formations sealed against pollution?
yes, no.

If YES depth of formation.

Why

Drillers Remarks:

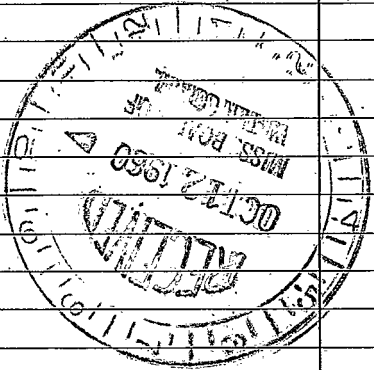

CODED

(Use Back Side)

Well No.

1914

1915

1916

1945