

# WATER WELL DRILLERS LOG

Lincoln  
05

Date: 14 Sept, 1966, Driller: J. T. Carngat Lincoln County Lincoln  
(Name)

CODED

(1) Owner of Land: Troy Washington  
(Name)

(Address)

(2) Location: SF 1/4, SW 1/4, Sec. 2 T5R6

8 miles West of Brandenburg  
(distance) (direction) (Nearest Town)

(3) Topography:  (Level)  
(Hilly) (Flat)

(4) Purpose of Well: Domestic  
(Domestic Irrigation, Municipal, Industrial, Other)

Description & Color of Materials  
Sand, Clay, Red Clay, Shell, etc.

Thick-  
ness  
Feet

Depth  
Feet

<u>Clay</u>	<u>20</u>	
<u>Sand clay</u>	<u>10</u>	<u>30</u>
<u>Sand</u>	<u>10</u>	<u>40</u>
<u>Chalk</u>	<u>15</u>	<u>55</u>
<u>Sand</u>	<u>33</u>	<u>88</u>

### Information upon completion of well:

(1) Diameter 4" inches.

(2) Total Depth 88' feet.

(3) Water Level 65' feet below top of ground.

(4) Cased to 88', Size 4"

(5) Screen: Size 1/2", Length 6'


(6) Were any formations sealed against pollution?  
\_\_\_\_\_ yes, \_\_\_\_\_ no.

If YES depth of formation \_\_\_\_\_

Why \_\_\_\_\_

Drillers Remarks: \_\_\_\_\_

CODED

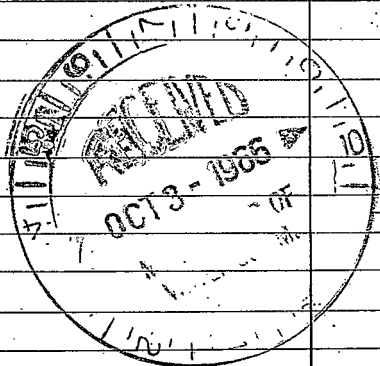

(Use Back Side)

Well No.

17